


T.17S.R.6W.W.M.

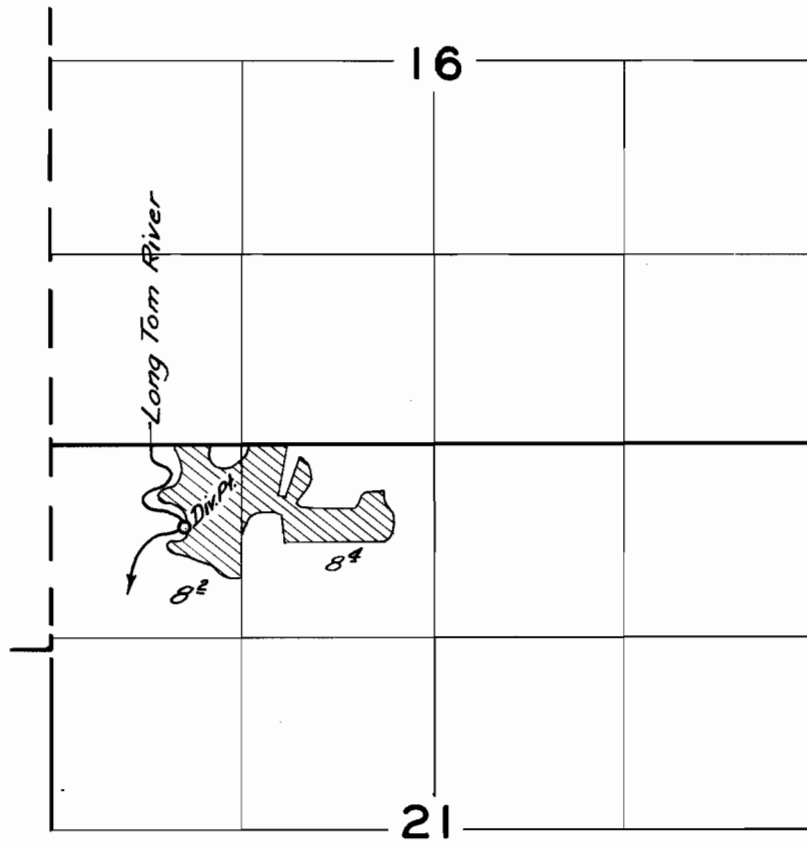

**FINAL PROOF SURVEY**  
UNDER

Application No. 29236... Permit No. 23004...  
IN NAME OF

..... *Harvey Fields* .....

Surveyed *May 4*, 1960, by *C. O. Baulta* .....