


T.16 S.R.6W.W.M.

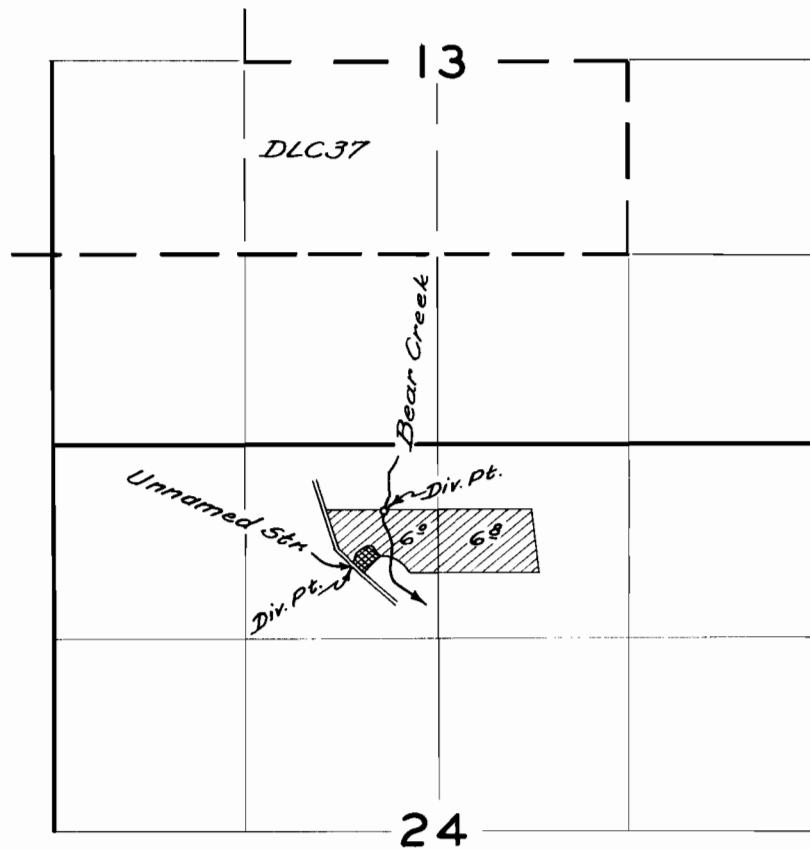

FINAL PROOF SURVEY
UNDER

Application No. 30732 Permit No. 24204
IN NAME OF

H.C. Osborne

Surveyed May 2, 1960, by C.O. Bartels