


T.18S.R.5W.W.M.

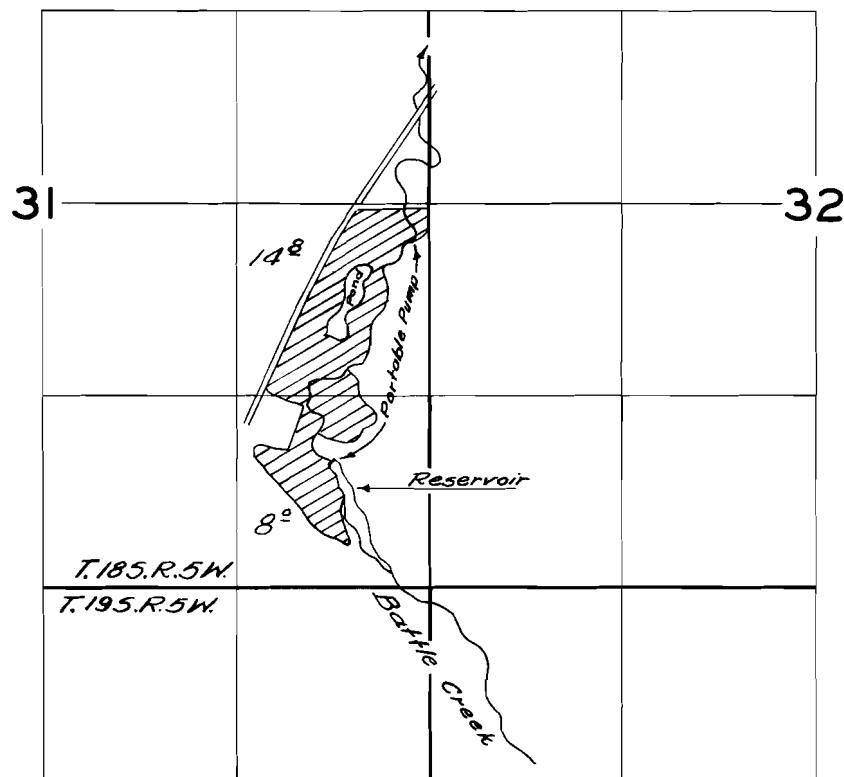

FINAL PROOF SURVEY
UNDER

Application No. *R-29801* *29806* Permit No. *R-1988* *29719*
IN NAME OF

A. B. Smith

Surveyed *April 27 1960*, by *C. O. Bartels*