


T.20S. R.5WWM.

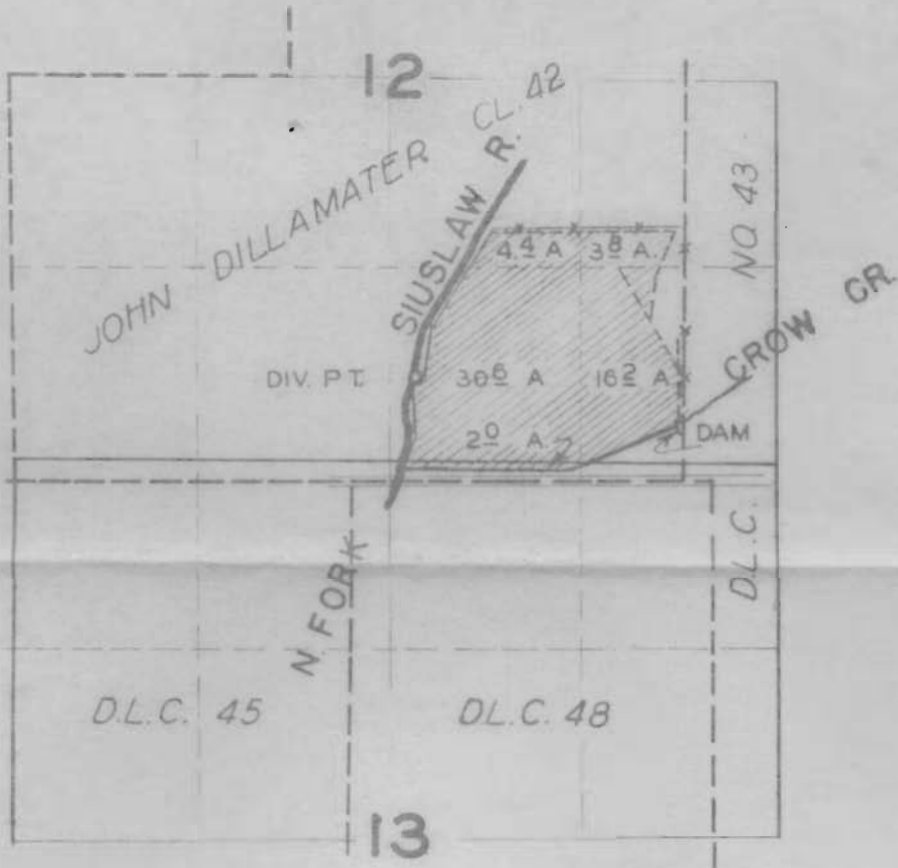

FINAL PROOF SURVEY
UNDER

Application No. 19318 Permit No. 14900
IN NAME OF

PAUL R. WILLIAMSON

Surveyed MAY 1 1951, by H.L. COFFMAN

Application No. 31692
Permit No. 25031