


T.18S. R.5W.W.M.

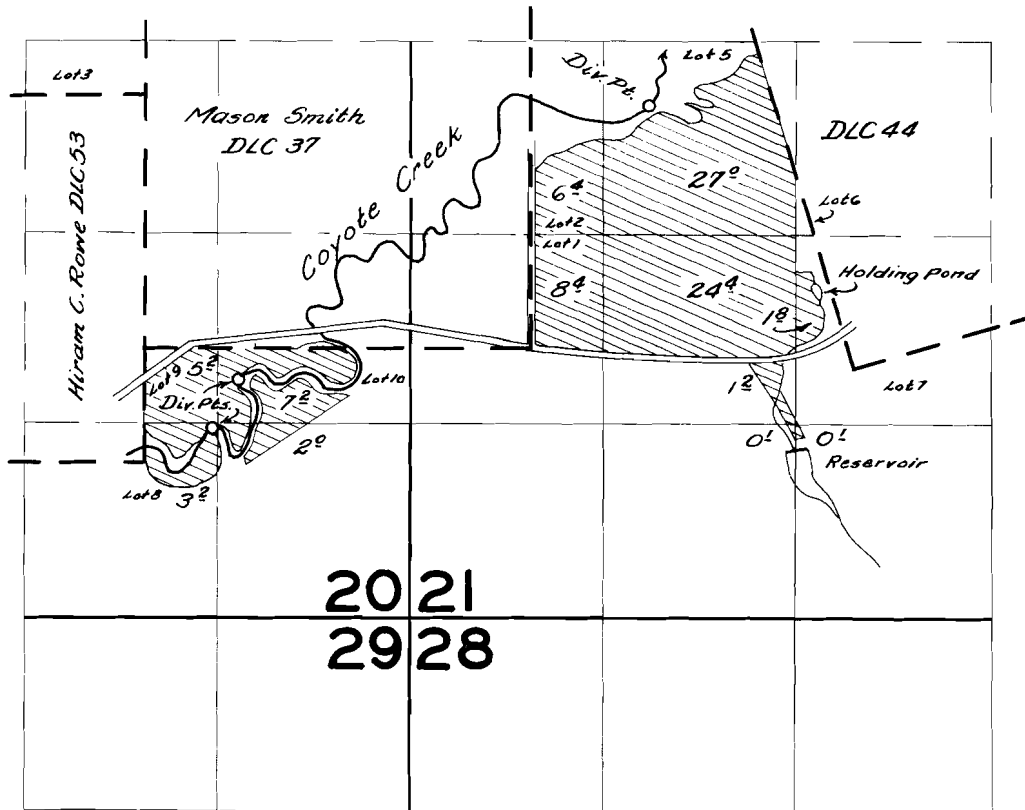

FINAL PROOF SURVEY
UNDER

Application No. R-32230 Permit No. R-2122
32231 25427
IN NAME OF

Emil F. & Nell S. Rahe

Surveyed March 31 1959, by *C.C. Bartlett*