


T.18S. R.5W.W.M.

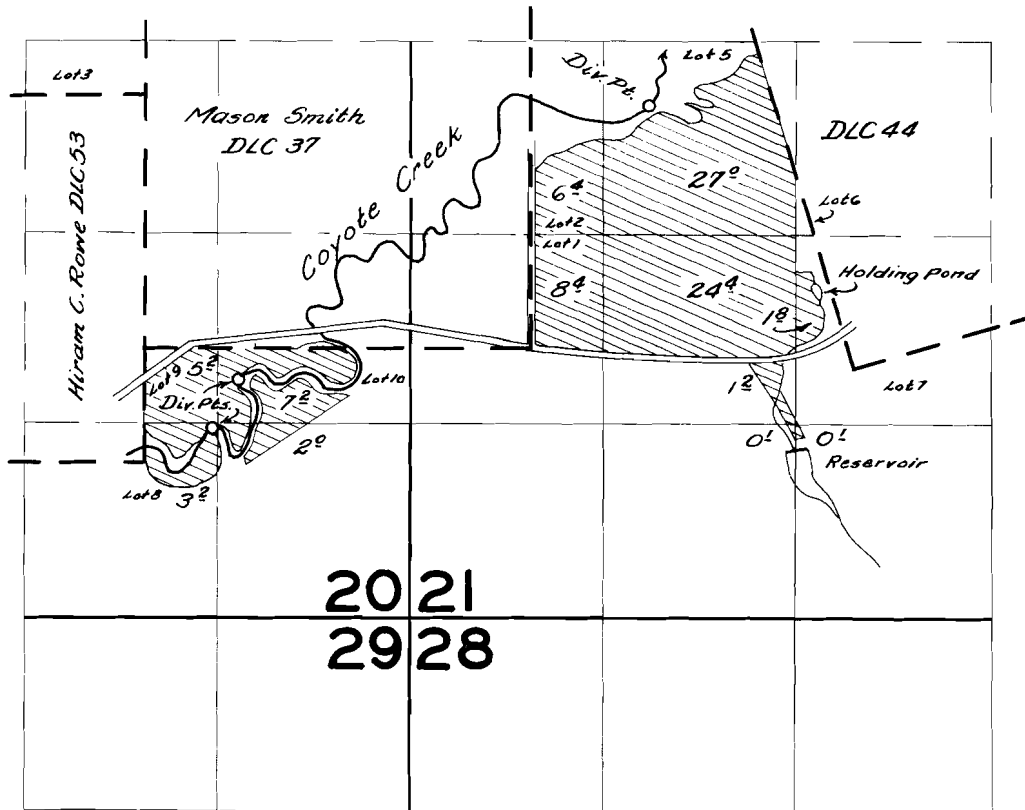

**FINAL PROOF SURVEY**  
UNDER

Application No. R-32230 Permit No. R-2122  
32231 25427  
IN NAME OF

*Emil F. & Nell S. Rahe*

Surveyed March 31 1959, by *C.C. Bartlett*