


T.17S.R.6W.W.M.

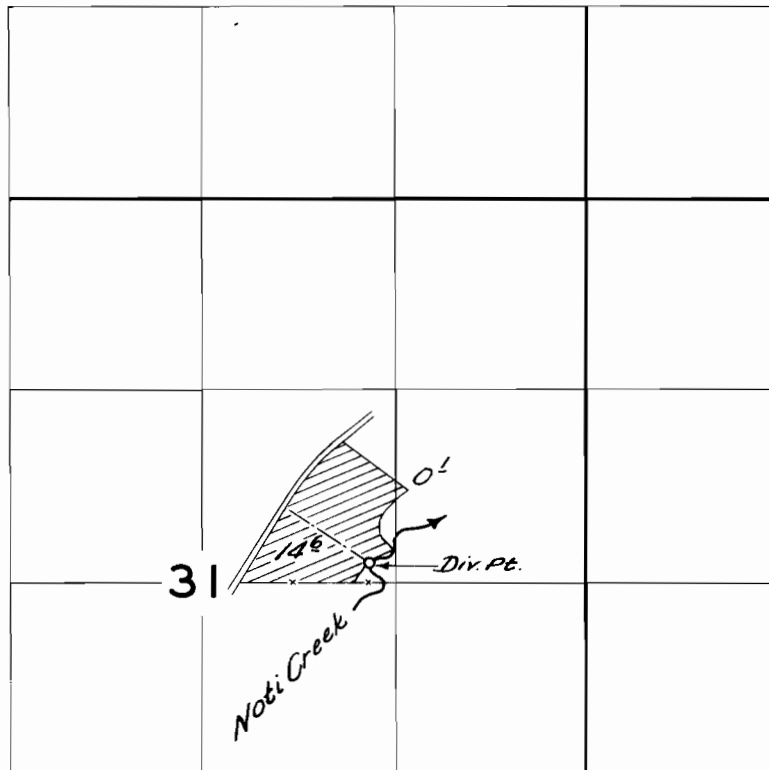

FINAL PROOF SURVEY
UNDER

Application No. 32311 Permit No. 25501
IN NAME OF

Roy Swearingen

Surveyed April 29 1960, by C.O. Baultel