


T.16S. R.5W.W.M.

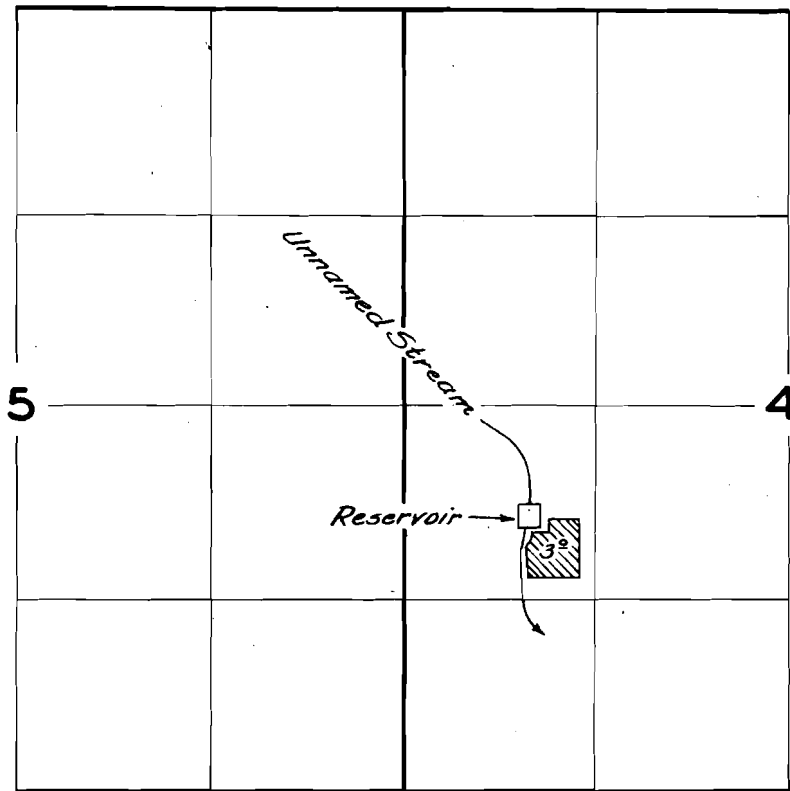

FINAL PROOF SURVEY
UNDER

Application No. ^{R-32319} 32320 Permit No. ^{R-2135} 25505
IN NAME OF

..... CLAUDIE H. SANDERS

Surveyed April 26 1960, by C.O. Bautek.....