


T.17 S.R. 2 W.W. M.

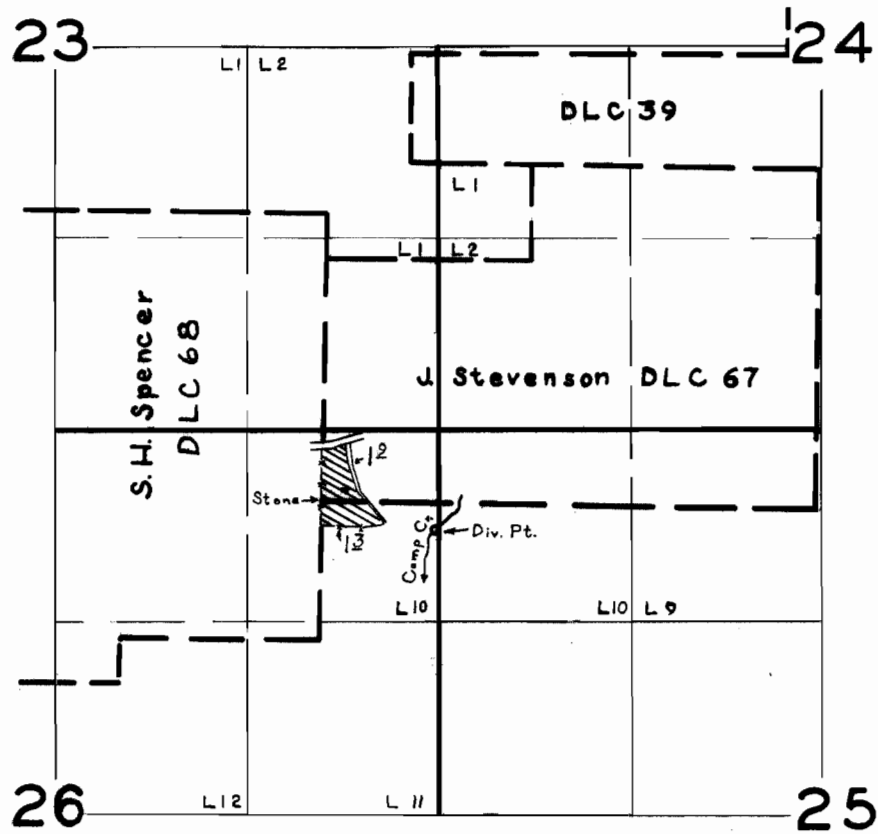

FINAL PROOF SURVEY
UNDER

Application No. 33074 Permit No. 26156
IN NAME OF

Willis Delbert Smith

Surveyed May 4, 1960, by M. Bish