


T. 12S. R. 1W. WM.

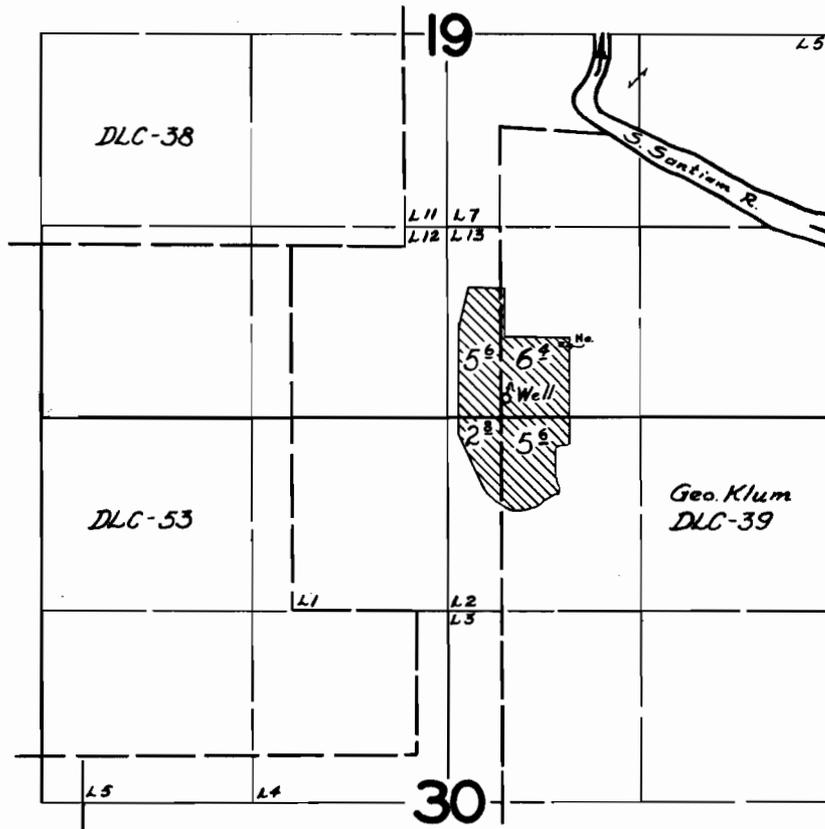

FINAL PROOF SURVEY

UNDER

Application No. G-545 Permit No. G-452

IN NAME OF

Frank Kennedy

Surveyed Aug. 28, 1959, by C. O. Bartels