


T.10S.R.3W.W.M.

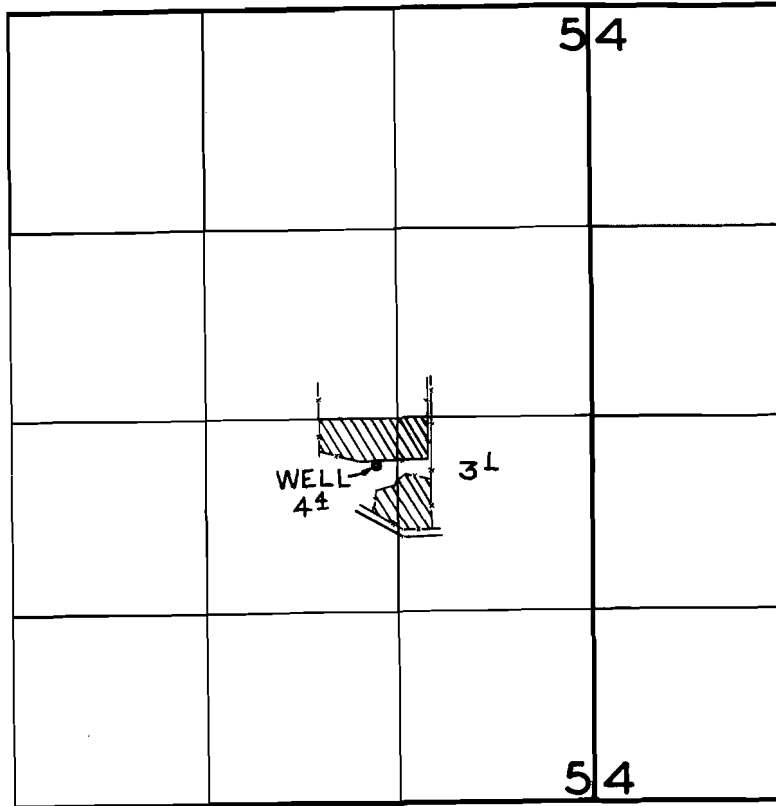

FINAL PROOF SURVEY
UNDER

Application No. G-15.74 Permit No. G-1435.
IN NAME OF

JACK PESHECK

Surveyed JUNE 23 1960, by M. BISH