


T. 12S. R. 1W. W.M.

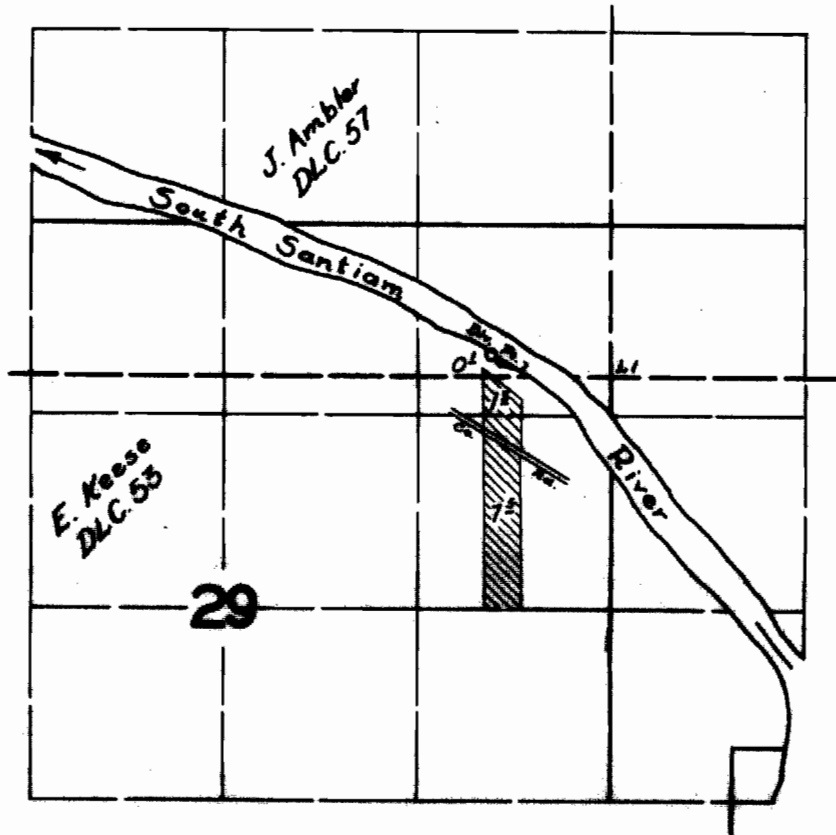

FINAL PROOF SURVEY

UNDER

Application No. 29688 Permit No. 23376

IN NAME OF

Arthur & Adaline Rieme

Surveyed Aug. 27 1959, by C. O. Bartels