


T. 14S. R. 2W. W.M.

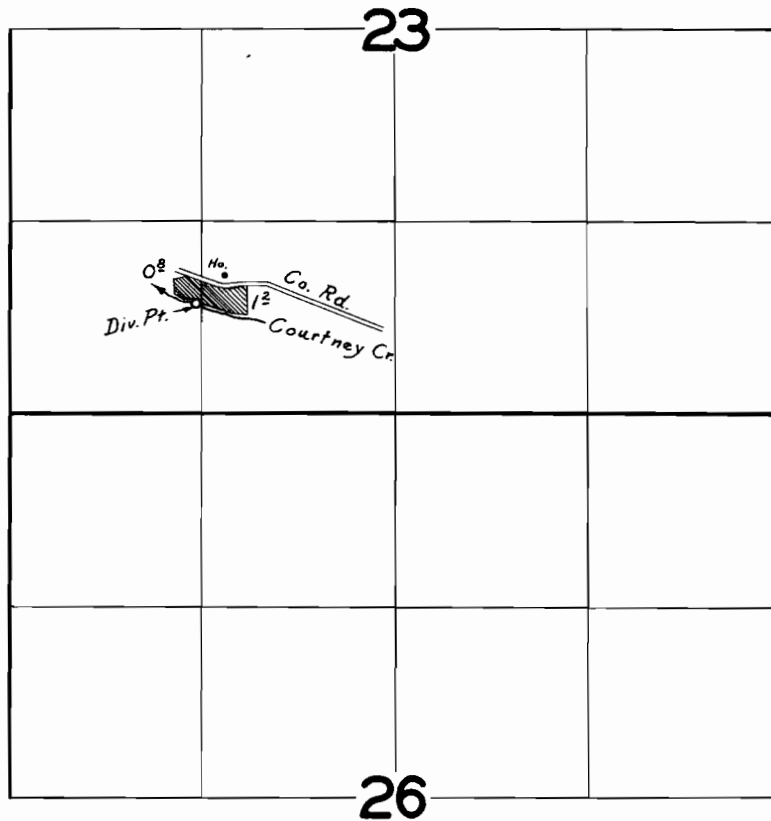

FINAL PROOF SURVEY

UNDER

Application No. 30447 Permit No. 23909

IN NAME OF

O. M. Roberts

Surveyed Sept. 3 1959, by C. O. Bartels