


T.13S. R. 3E.W.M.

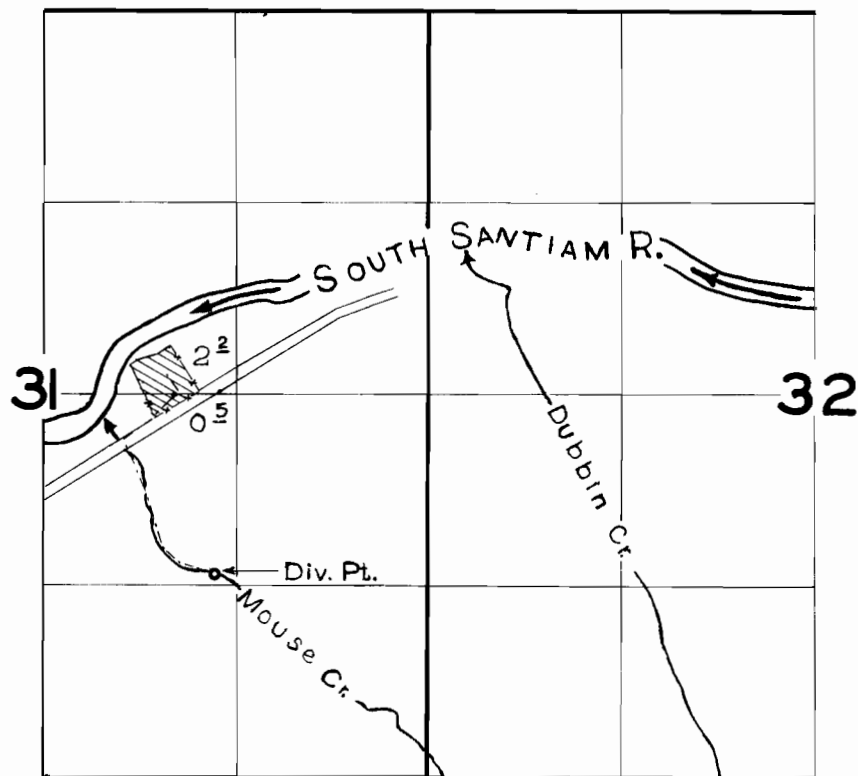

FINAL PROOF SURVEY
UNDER

Application No. 31463 Permit No. 24808
IN NAME OF

JOSEPH R. & HAZEL WALKER

Surveyed MAY 9, 1960, by M. BISH