


T. 7S. R. 2W. W.M.

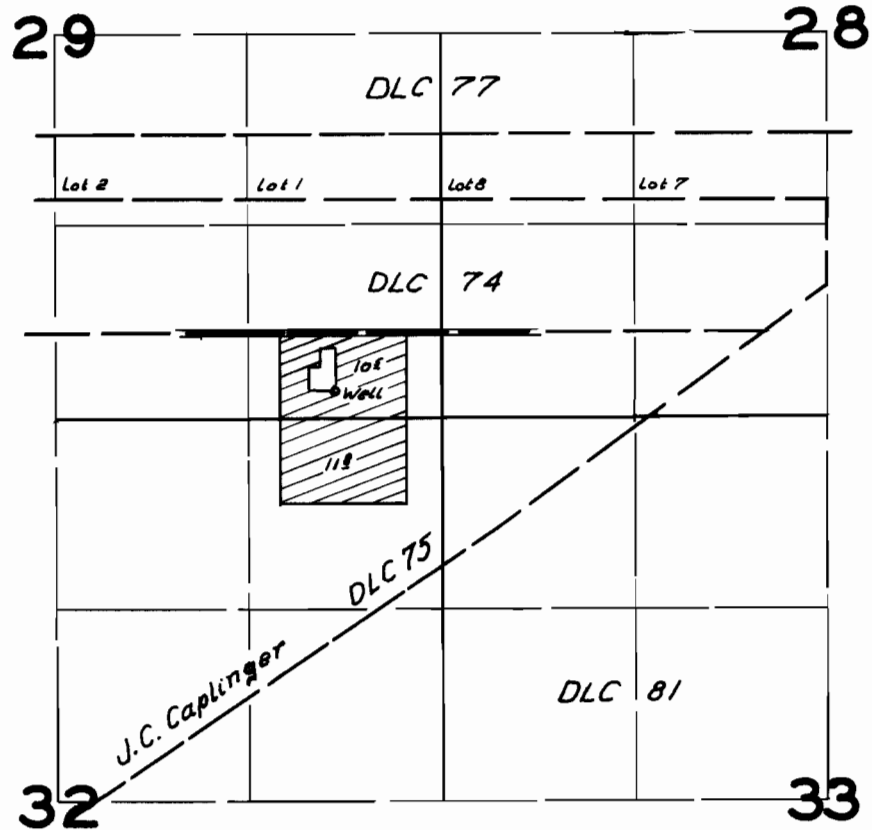

FINAL PROOF SURVEY
UNDER

Application No. *G411* Permit No. *G285*
IN NAME OF

H.A. Wilson

Surveyed *July 6* 1959, by *C.O. Bartels*