T. 7S. R. 2W. W.M.

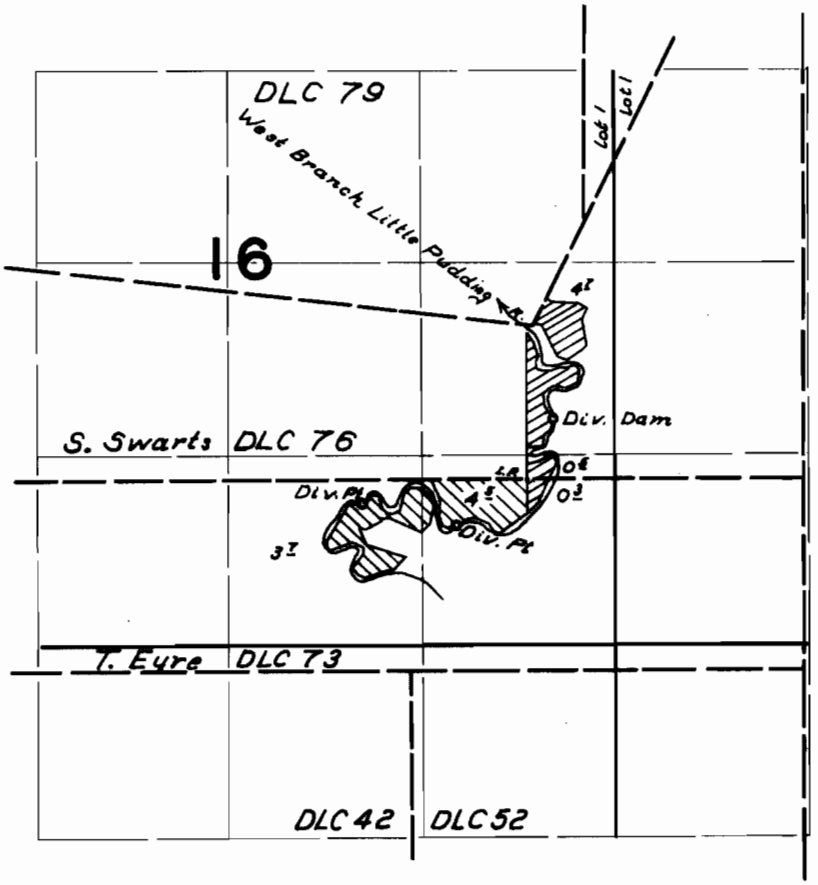

FINAL PROOF SURVEY
UNDER

Application No. 26000 Permit No. 20370
IN NAME OF
Earl Bushnell
Howard A. Klopfenstein

Surveyed June 12 1959, by R.H. Jackson

1959-0