


T. 6S. R. 1W. W.M.

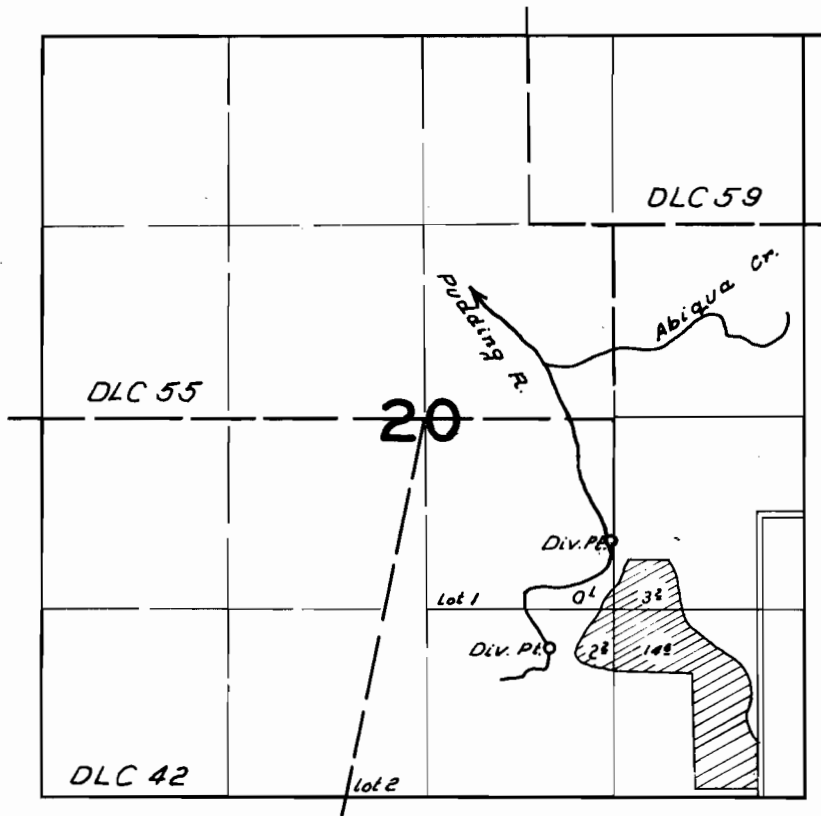

FINAL PROOF SURVEY
UNDER

Application No. 29982. Permit No. 23757...
IN NAME OF

Harold Satern

Surveyed *May 27 19 59* by *C.O. Bartels*...