


T.6 S.R.I W.W.M.

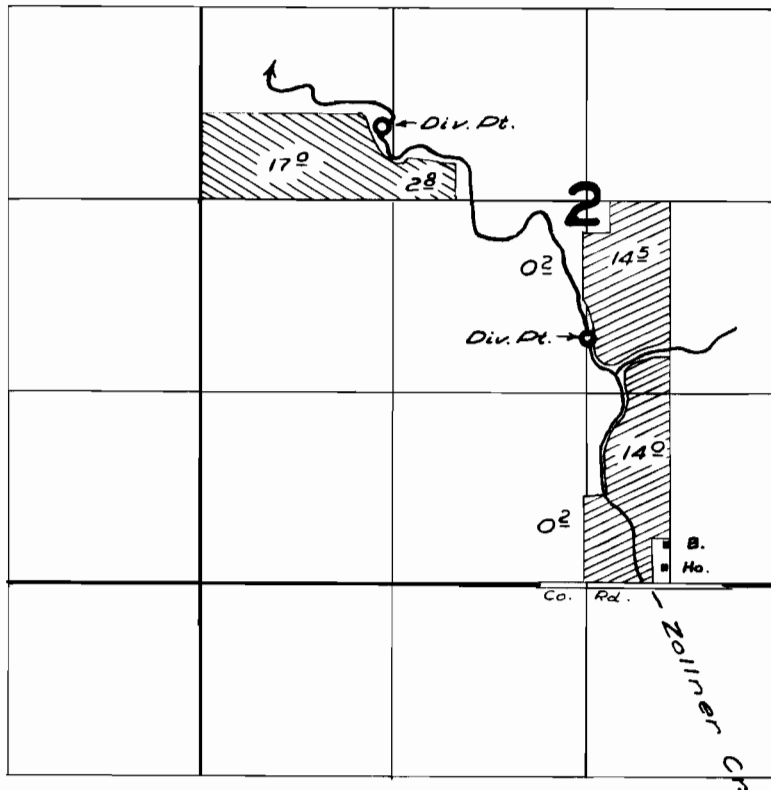

FINAL PROOF SURVEY UNDER

Application No. 31105..... 24471
31106..... Permit No. 24472
 IN NAME OF



..... ANTHONY P. KRAEMER

Surveyed 1 April 1960, by M. Bish