


# T.6 S.R.I W.W.M.

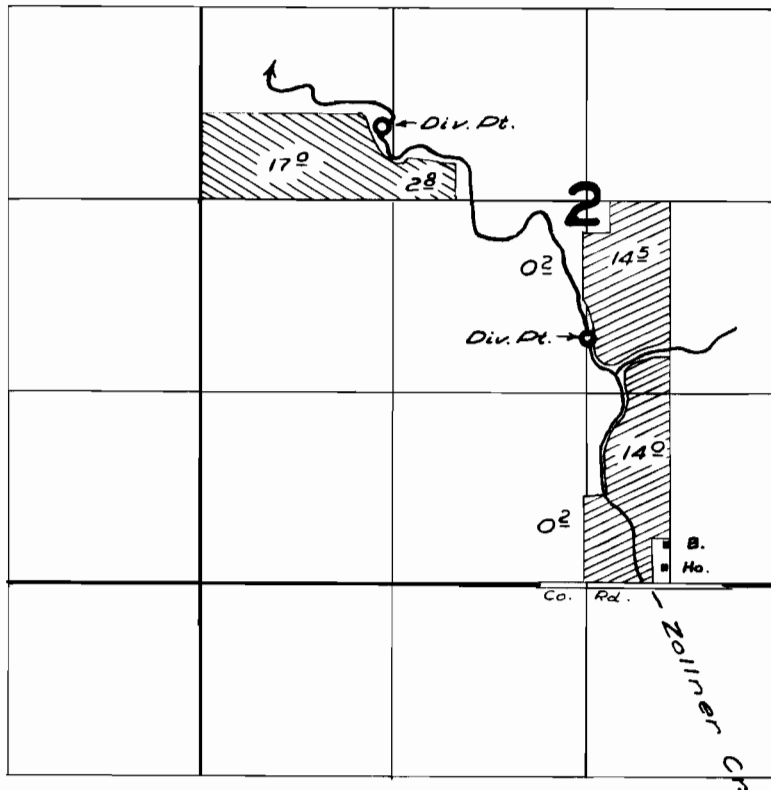

## FINAL PROOF SURVEY UNDER

Application No. 31105..... 24471  
31106..... Permit No. 24472  
IN NAME OF



ANTHONY P. KRAEMER

Surveyed 1 April 1960, by M. Bish