


T. 1N. R. 3E. W.M.

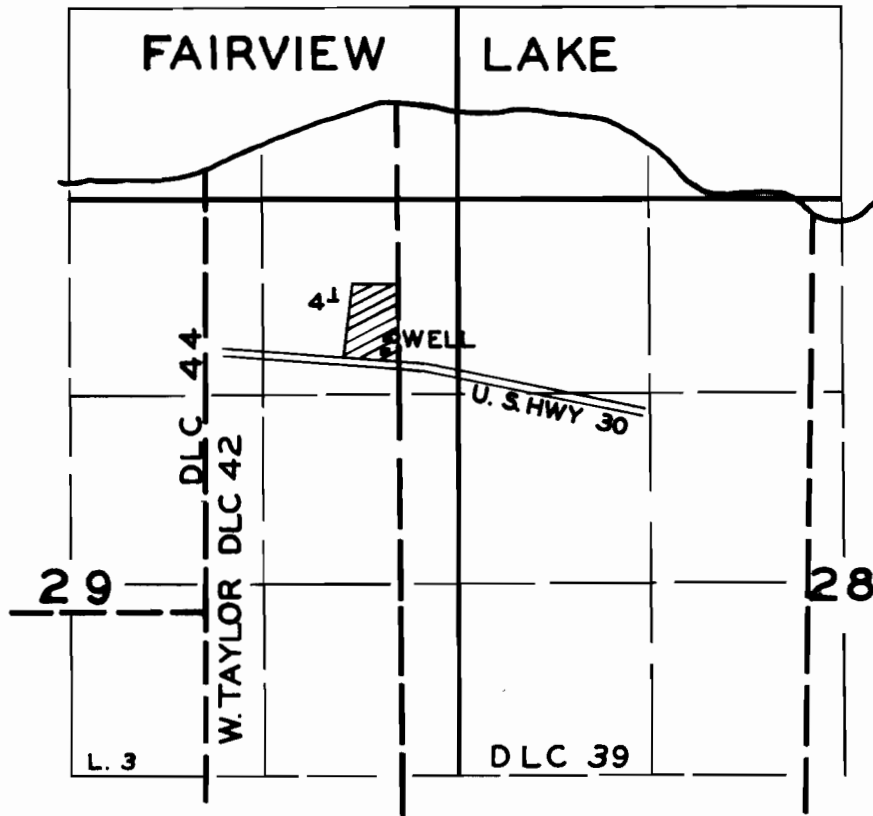

FINAL PROOF SURVEY
UNDER

Application No. G.1237 ... Permit No. G.1264 ...
IN NAME OF

K. KIKKAWA

Surveyed MAY.11 ... 19.60, by G. O. BARTELS