


# T I S. R. I E W. M.

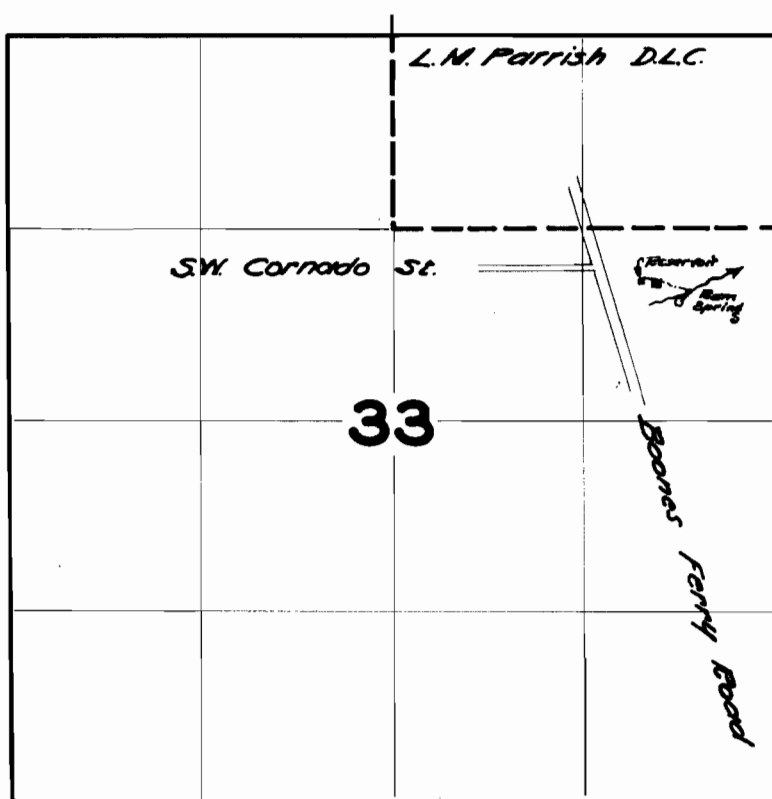

## FINAL PROOF SURVEY

UNDER

Application No. 17251... Permit No. 12958...

IN NAME OF

CHAS. C. SMITHERS

Surveyed 10/19... 1951... by H.L. COFFMAN.