


T. IN. R. IW. W.M.

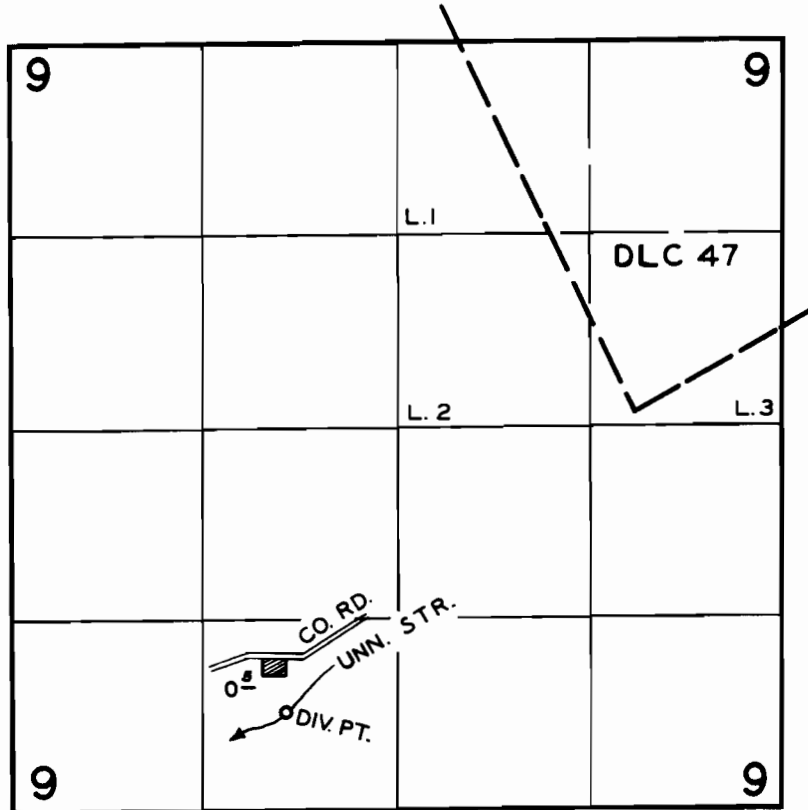

FINAL PROOF SURVEY UNDER

Application No. 19491..... Permit No. 15070.....
IN NAME OF

ARTHUR WISE.....

Surveyed JULY 5... 1960, by C. O. BARTELS.....