


T. 4S. R. 10W. W.M.

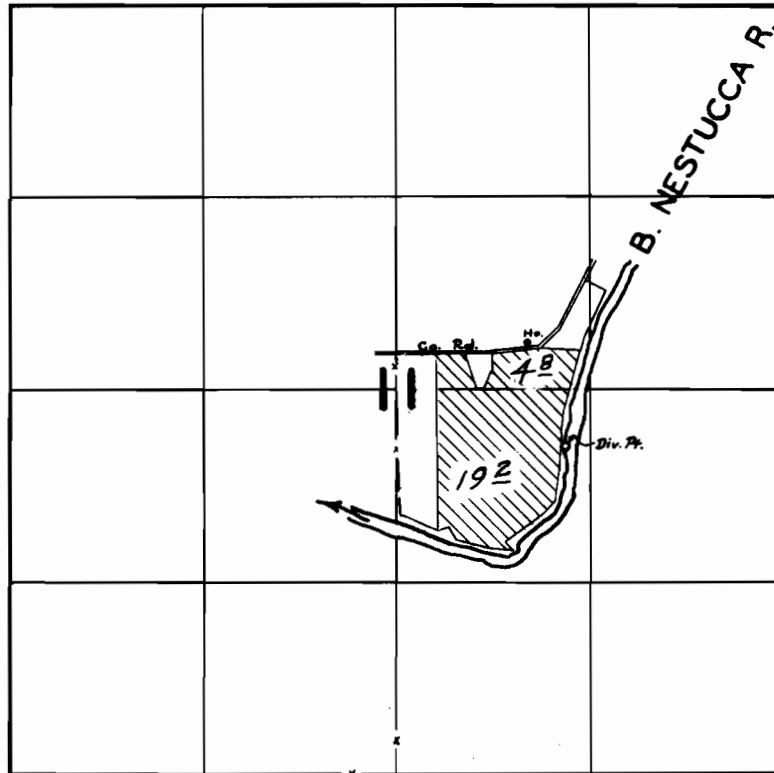

FINAL PROOF SURVEY
UNDER

Application No. 28201. Permit No. 22189
IN NAME OF

ROBERT E. WILSON

Surveyed APR. 20 1959, by M. BISH