


T. 4 N. R. 29 E. W. M.

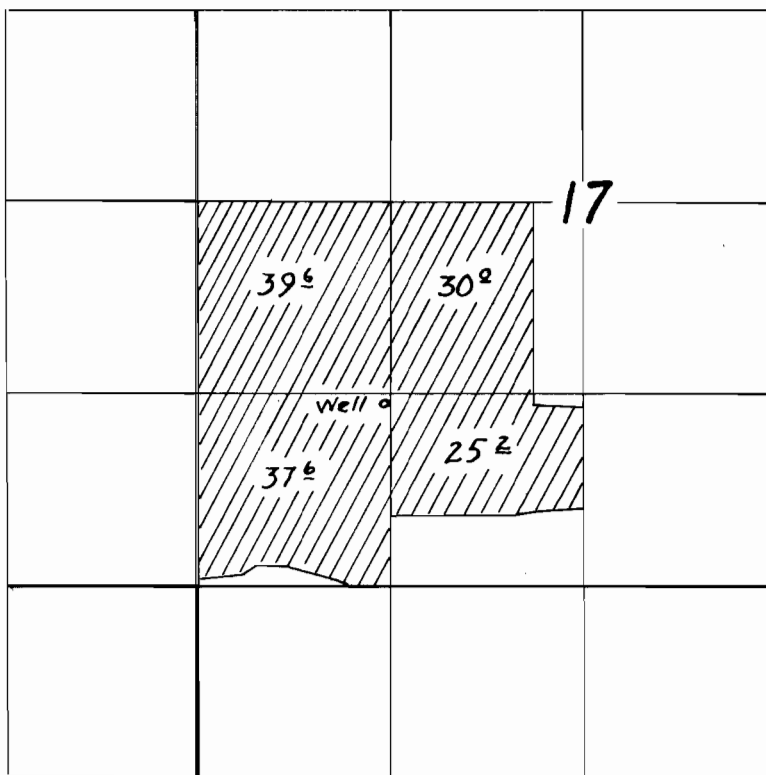

FINAL PROOF SURVEY
UNDER

Application No. U-519 Permit No. U-489
IN NAME OF

Ben Dreyer

Surveyed NOV 17 1958, by M. BISH