


T. 6S. R. 10W. W.M.

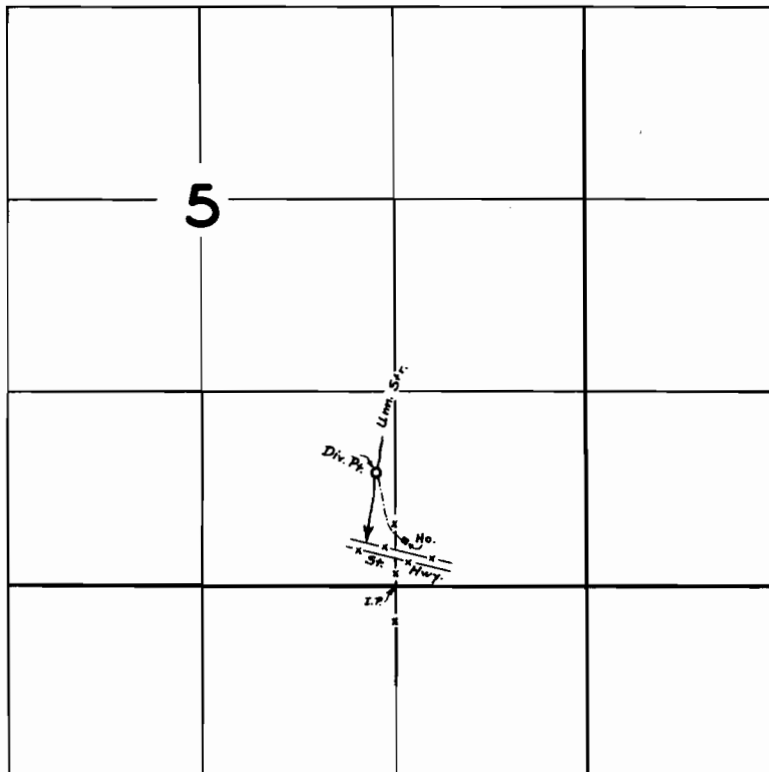

FINAL PROOF SURVEY
UNDER

Application No. 32069 Permit No. 25321
IN NAME OF

HARRY OR CLARA POLAND

Surveyed APR. 17 1959, by M. BISH