


T. 3 S. R. 39 E. W.M.

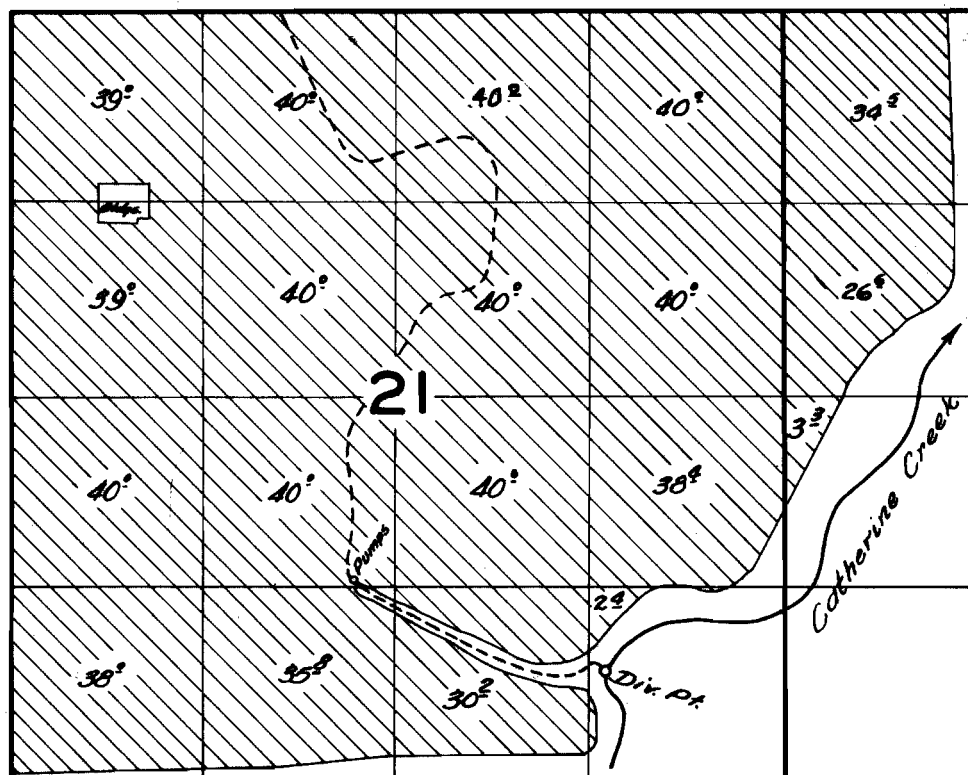

FINAL PROOF SURVEY

UNDER

Application No. 2444A Permit No. 19920

IN NAME OF

Frank LeRoux Inc.

Surveyed Aug. 5, 1959, by C.O. Baile