


T.2S. R.39E.W.M.

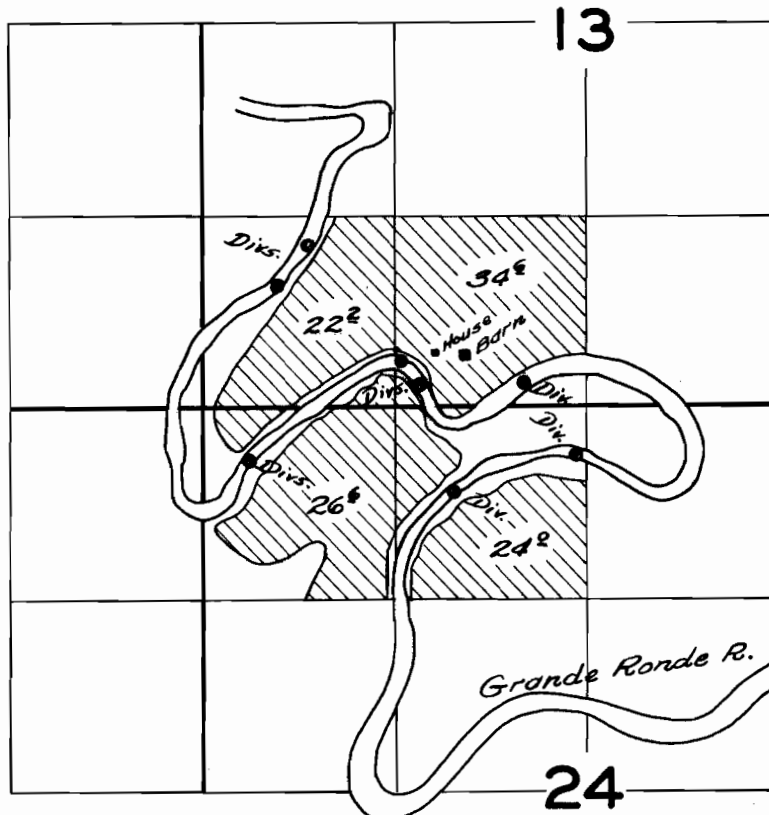

FINAL PROOF SURVEY

UNDER

Application No. 26740 Permit No. 20924

IN NAME OF

Surveyed Aug. 7, 1959, by C. C. Baugh