


V553

T. 1N. R. 12E. W.M

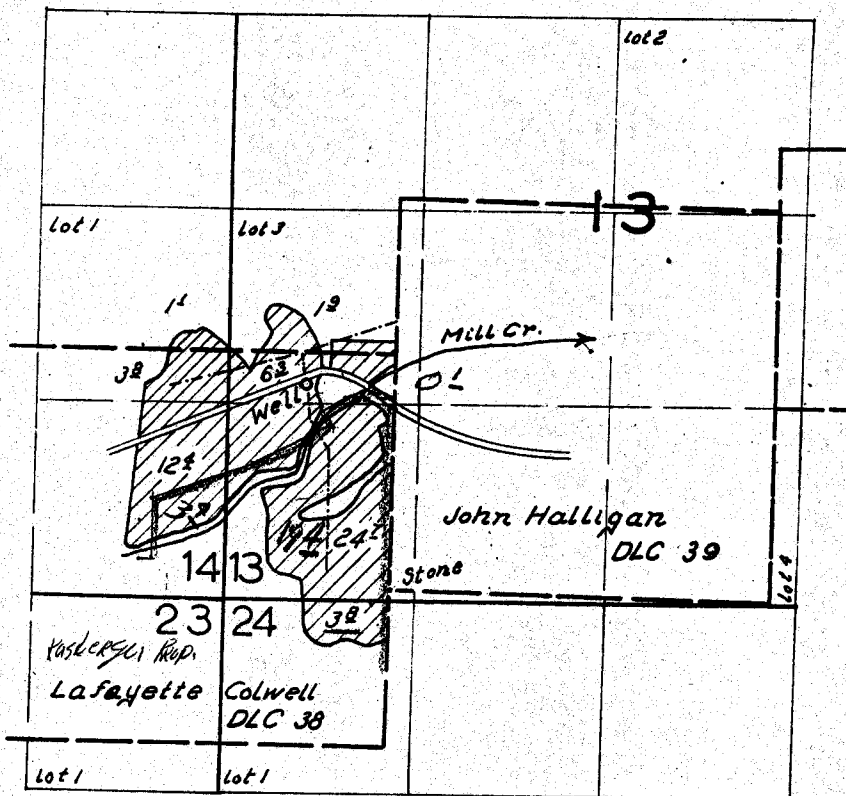

FINAL PROOF SURVEY UNDER

Application No. U603 Permit No. U553
IN NAME OF

Julius Sandoz

Surveyed Nov. 11, 1959 by R.H. Jackson

55-35-9