


# T. 1 N. R. 12 E. W.M.

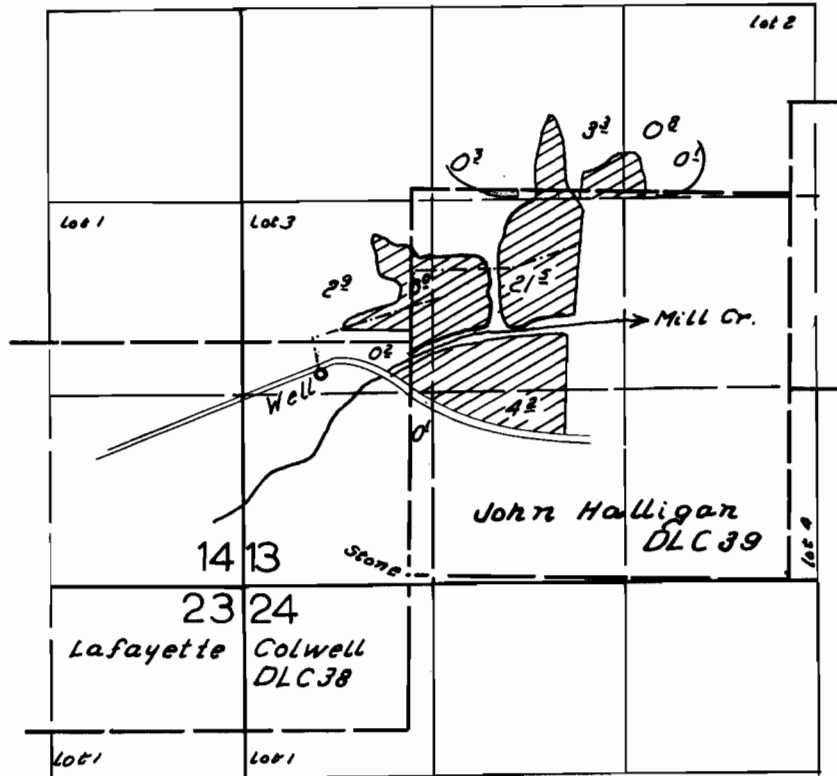

## FINAL PROOF SURVEY UNDER

Application No. *U.734*..... Permit No. *U.662*.....  
IN NAME OF

.....*Julius Sandoz*.....

Surveyed *Nov. 11*... 1959, by *R. H. Jackson*.....