


T. IN. & IS. R. 4W. W.M.

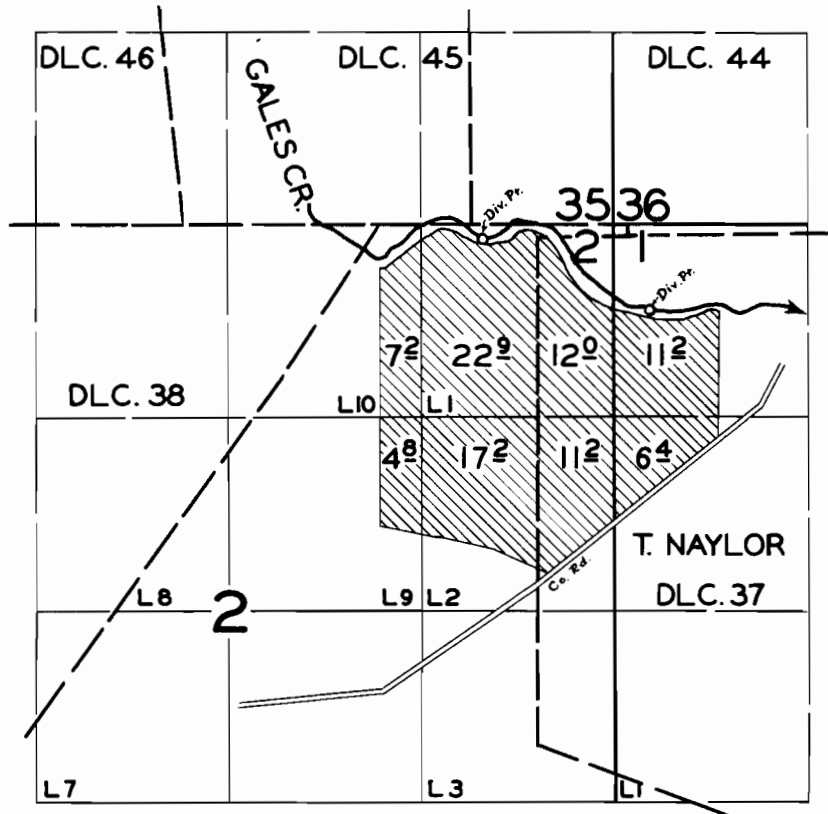

FINAL PROOF SURVEY UNDER

Application No. 29759 Permit No. 23438
IN NAME OF

MYRON SHEELAR

Surveyed JUNE 2, 1959, by M. BISH