


T.2S. R. 2 W.W.M.

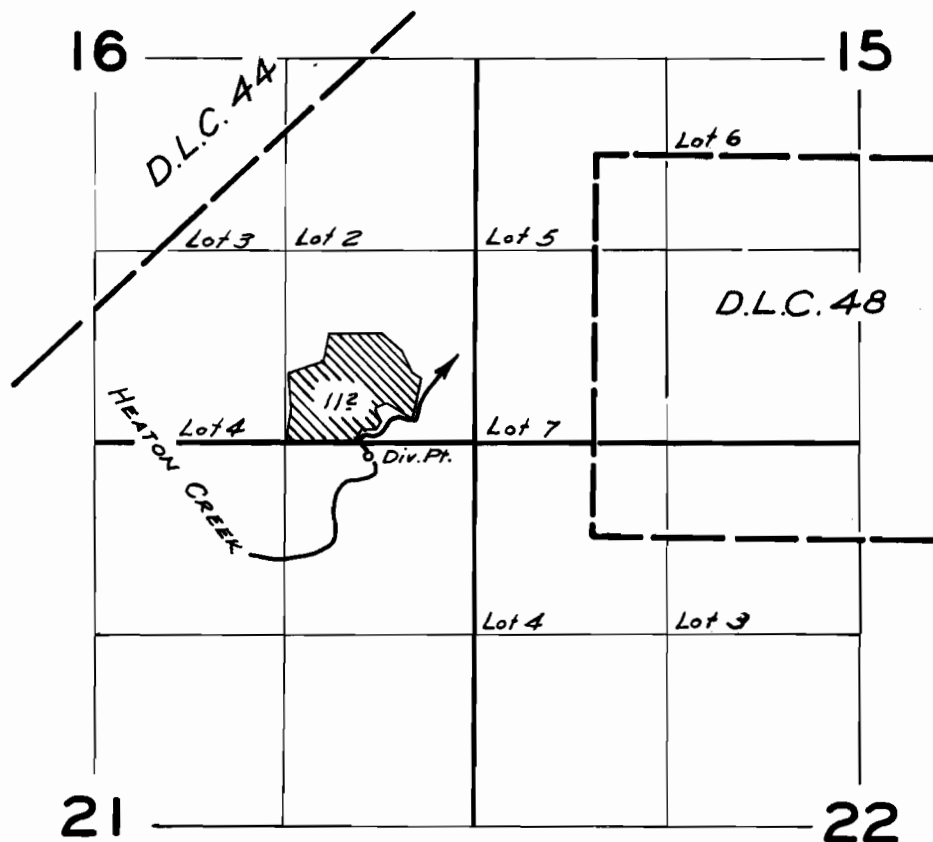

FINAL PROOF SURVEY
UNDER

Application No. 32135... Permit No. 25349...
IN NAME OF

E. L. SEIFFERT

Surveyed June 1, 1960, by R. Jackson