


T. 5S. R. 6W. W.M.

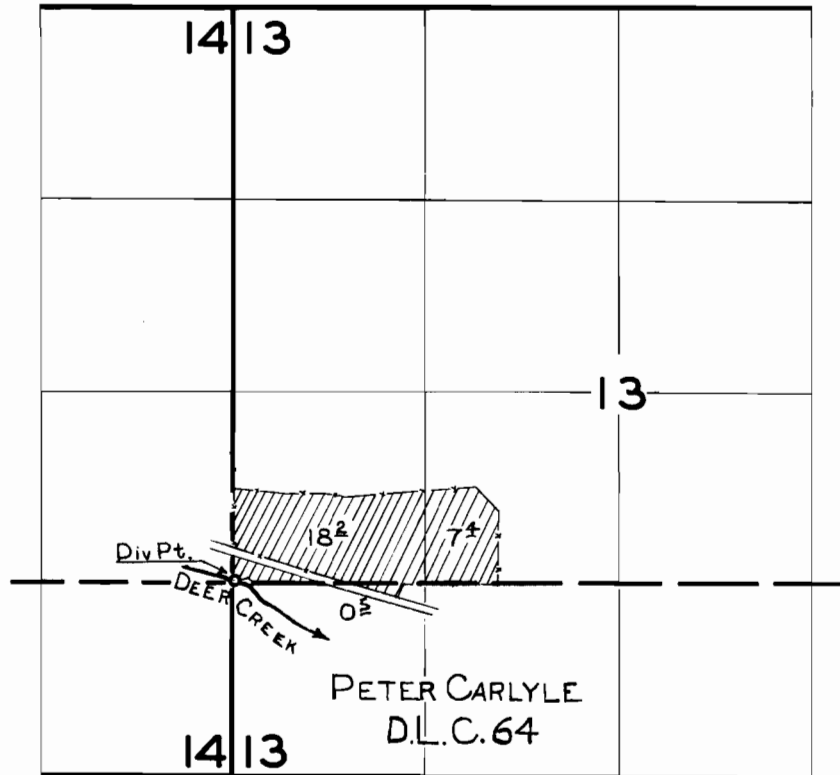

FINAL PROOF SURVEY
UNDER

Application No. 31052... Permit No. 24400.
IN NAME OF

..... STEPHEN E. POTTER

Surveyed MAY 18, 1960, by M. BISH