


# T. 6S. R. 1W. W.M.

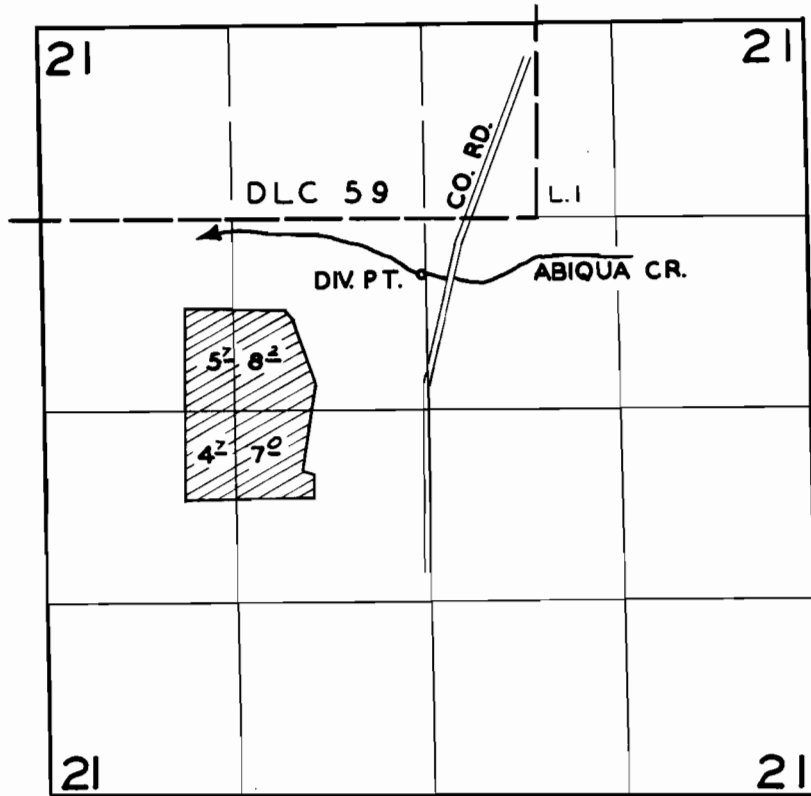

## FINAL PROOF SURVEY UNDER

Application No. 31149..... Permit No. 24486.....  
IN NAME OF

..... R. C. & STELLA PETTIT.....

Surveyed MAY 23 19 60, by C. O. BARTELS.....