


4019
2804

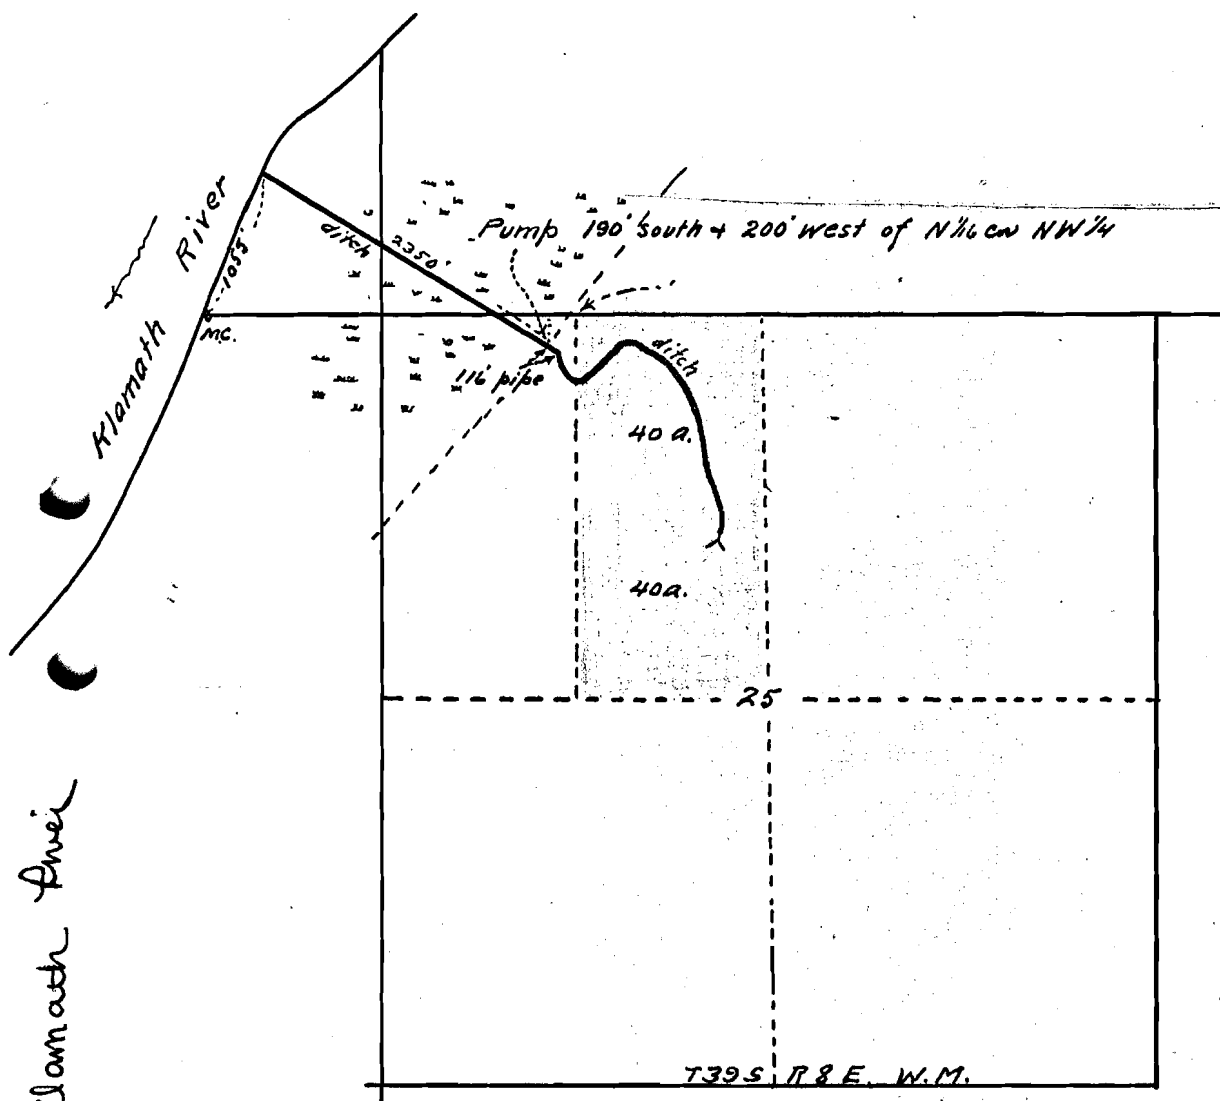

Application No. 0101
Permit No. 4019

Klamath River

OFFICE OF STATE ENGINEER
RECEIVED
MAR 15 1919
J. C. CLEGHORN

- MAP OF EDGAR L. FURBER Ditch -

Accompanying application for permit to appropriate
water of Klamath River.

Scale 1" = 20 chs.

March 5, 1919.

This map was made by J.C. Cleghorn, C.E. from information and measurements
furnished by Mr. Furber.