


# T.10S.R.6W.W.M.

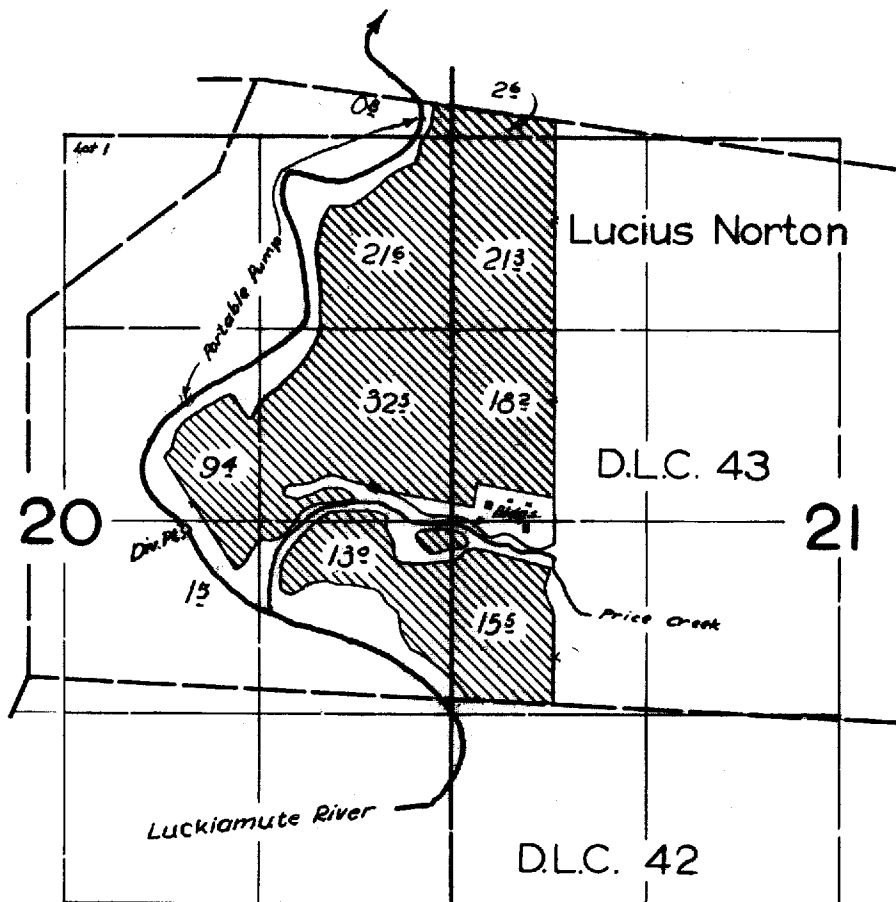

## FINAL PROOF SURVEY UNDER

Application No. 26230. Permit No. 21121  
IN NAME OF

*M.G. & RACHEL C. MCCORMAC*

Surveyed 11 March 1959, by *R.H. Jackson*