


T. 3S. R. 4 E. W. M.

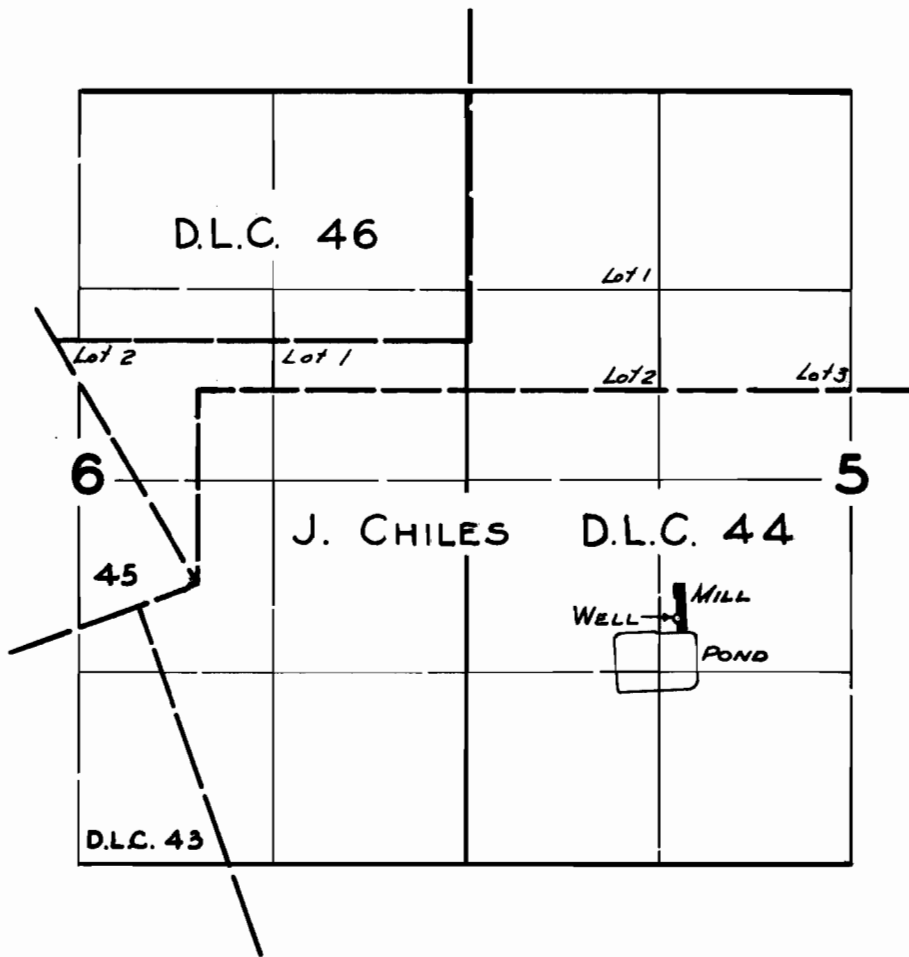

FINAL PROOF SURVEY
UNDER

Application No. G-260 Permit No. G-168
IN NAME OF

DIAMOND LUMBER CO.

Surveyed Mar. 30, 1960, by R. Jackson