


T.5S. R.1E.W.M.

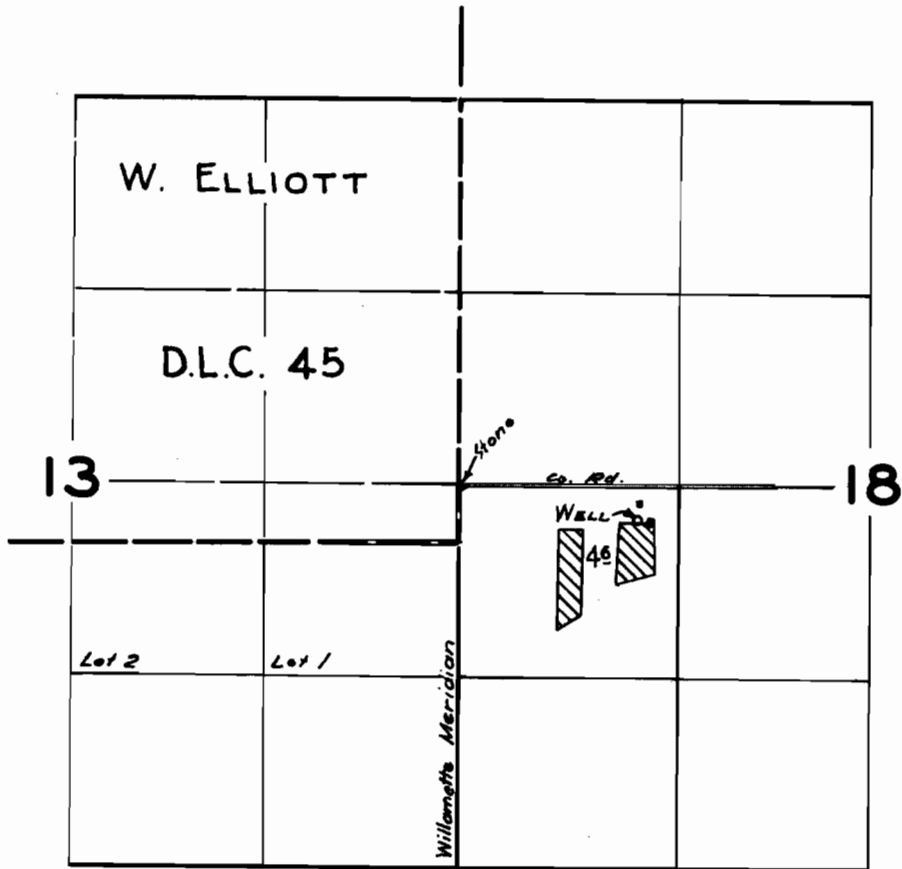

FINAL PROOF SURVEY
UNDER

Application No. G-295 Permit No. G-192
IN NAME OF

ERNEST S. ANDERSON

Surveyed April 29, 1959, by M. Bish