


# T. 3S. R. 1&2E.W.M.

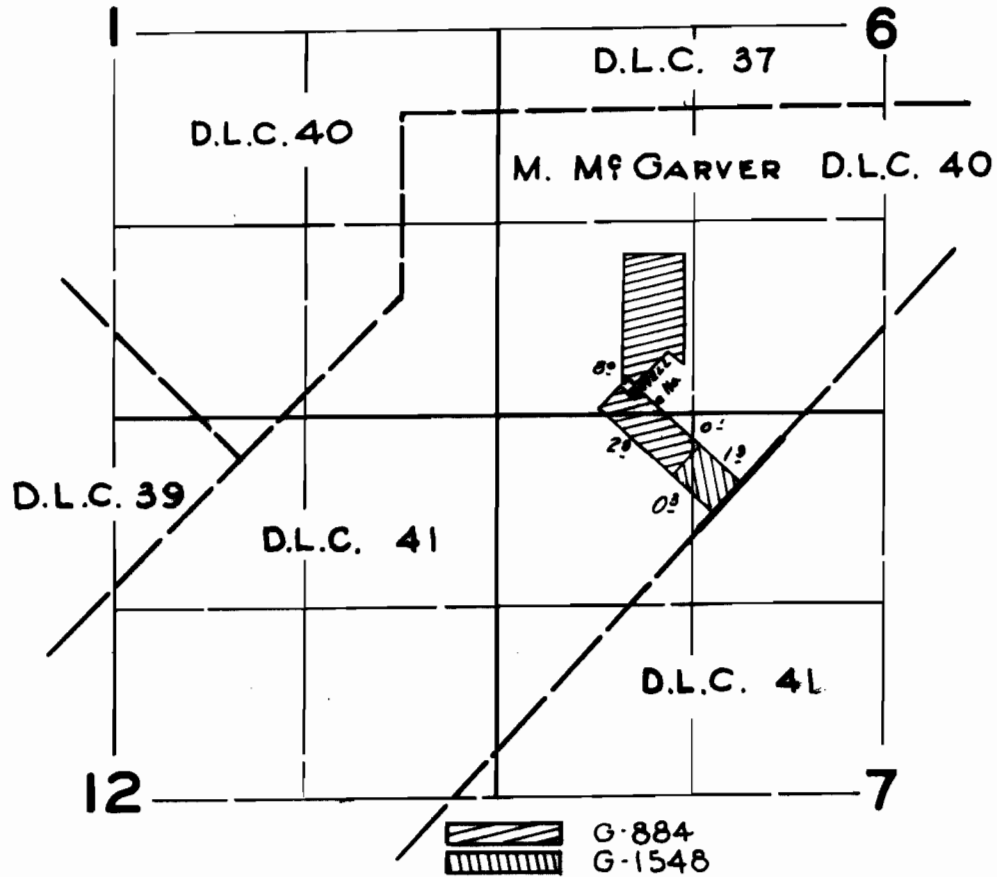

## FINAL PROOF SURVEY UNDER

Application No. <sup>G-884</sup>~~G-1548~~ Permit No. <sup>G-792</sup>~~G-1427~~  
IN NAME OF

**GUSTAV & MARGARET HEIN**

Surveyed Mar. 31, 1960, by *R. H. Jackson*