T. 3S. R.1&2E.W.M.

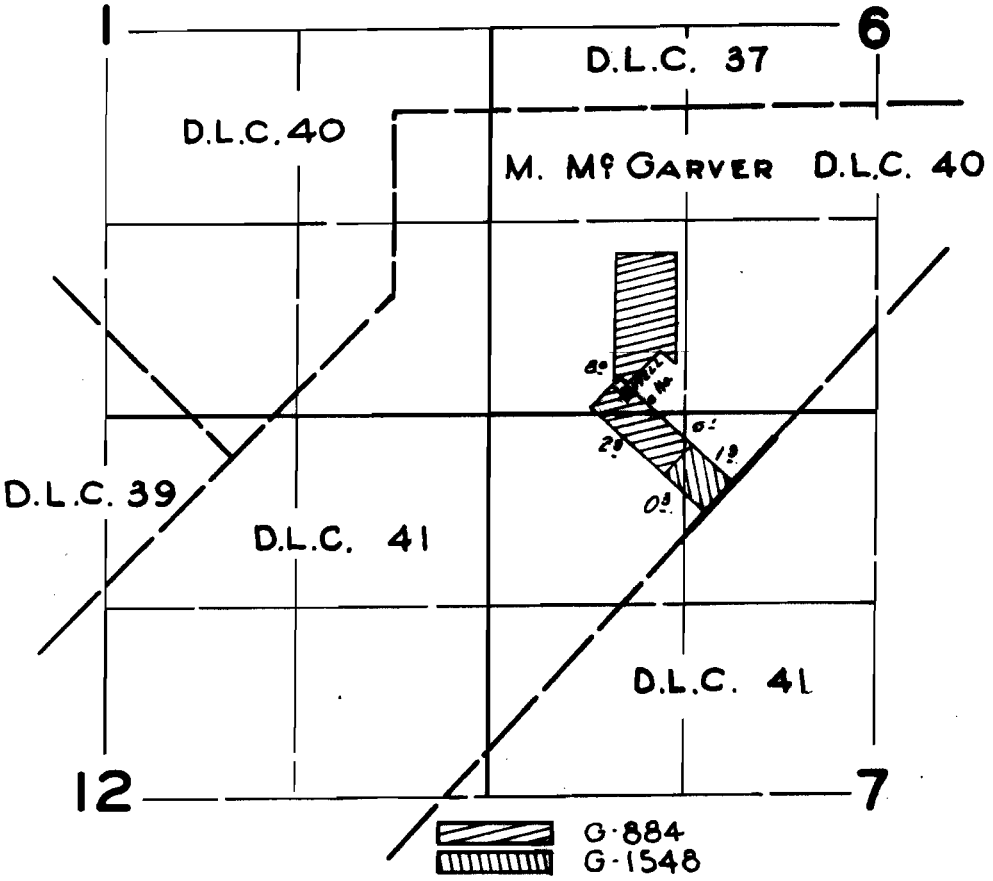

FINAL PROOF SURVEY
UNDER

Application No. G-884 G-1548 Permit No. G-792 G-1427
IN NAME OF

GUSTAV & MARGARET HEIN

Surveyed Mar. 31 1960, by R H Jackson

DFK-30-120