


T.2 S. R.1 E.W.M.

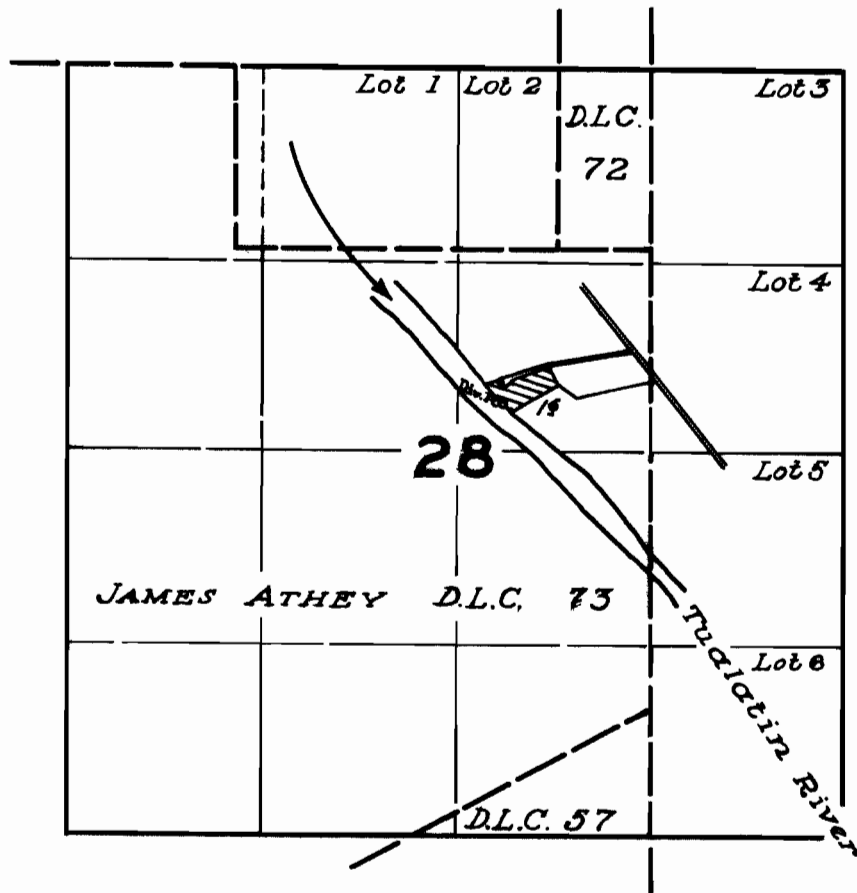

**FINAL PROOF SURVEY**  
UNDER

Application No. 29402 Permit No. 23267.  
IN NAME OF

HERBERT R. STRONG

Surveyed April 28 1960, by R. H. Jackson