


T.3S. R. 1W.W.M.

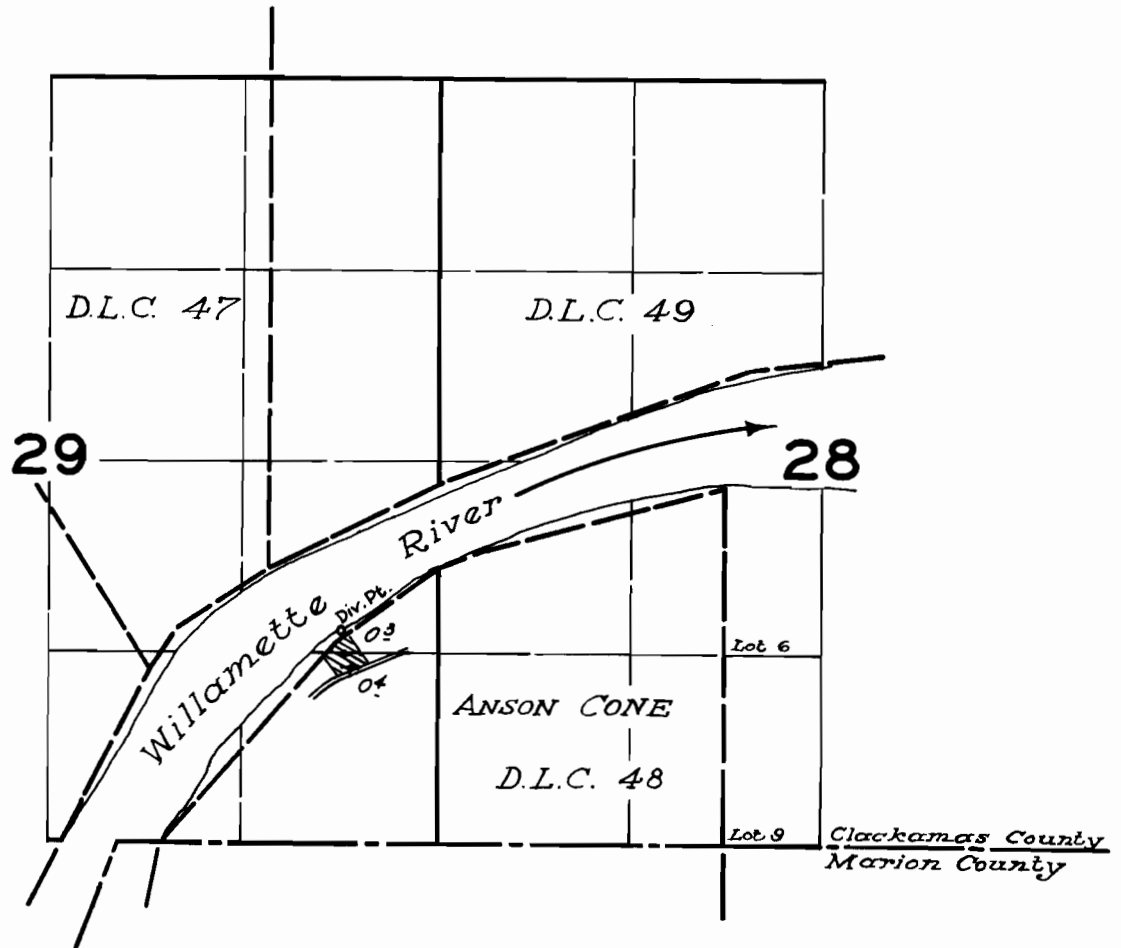

FINAL PROOF SURVEY UNDER

Application No. 30968... Permit No. 24356..
IN NAME OF

CYRIL H. & NINA VORPAHL

Surveyed April 25 1960, by *R. Jackson*