


T.3S. R 2 E.W.M.

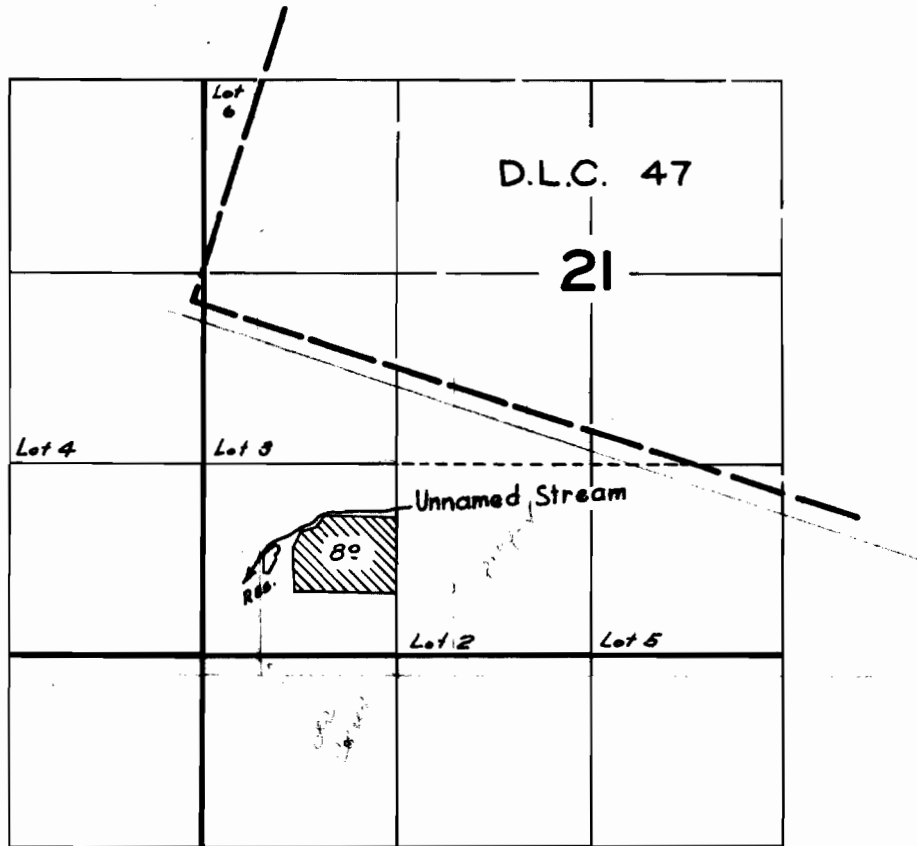

**FINAL PROOF SURVEY**  
UNDER

Application No. R-32129 3.2130 Permit No. R-2113 2.5347  
IN NAME OF

JOHN C. KRUGER

Surveyed Mar. 31. 1960, by L. Jackson