


T.3S. R 2 E.W.M.

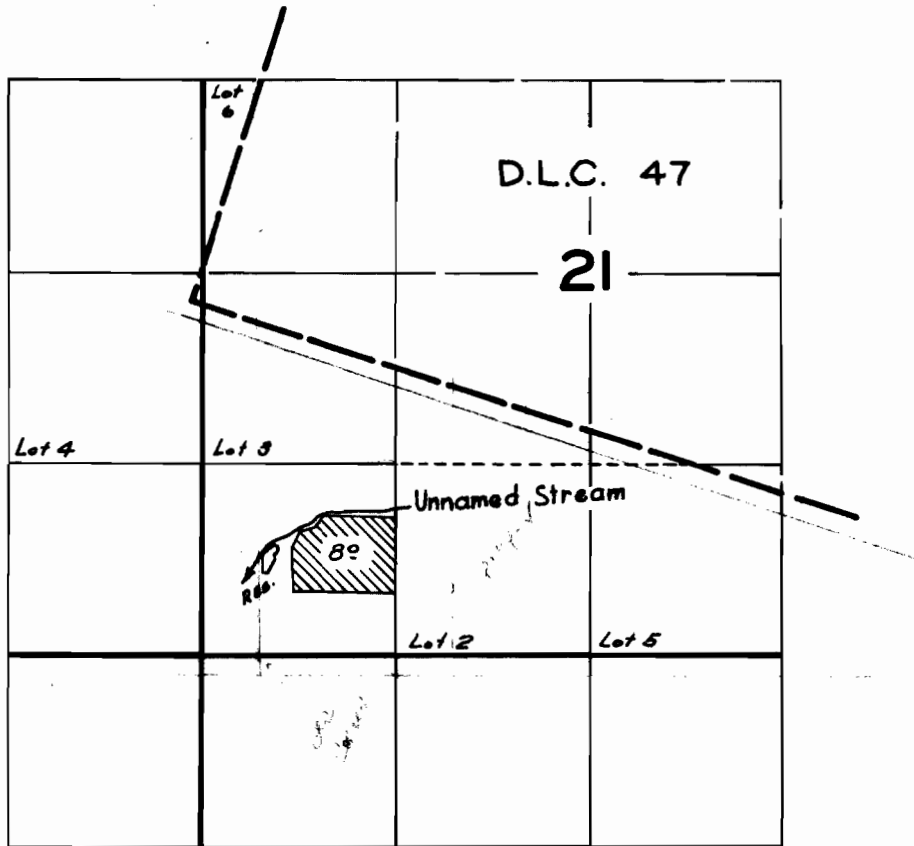

FINAL PROOF SURVEY
UNDER

Application No. R-32129 3.2130 Permit No. R-2113 2.5347
IN NAME OF

JOHN C. KRUGER

Surveyed Mar. 31, 1960, by L. Jackson