


T.3S. R.1E.W.M.

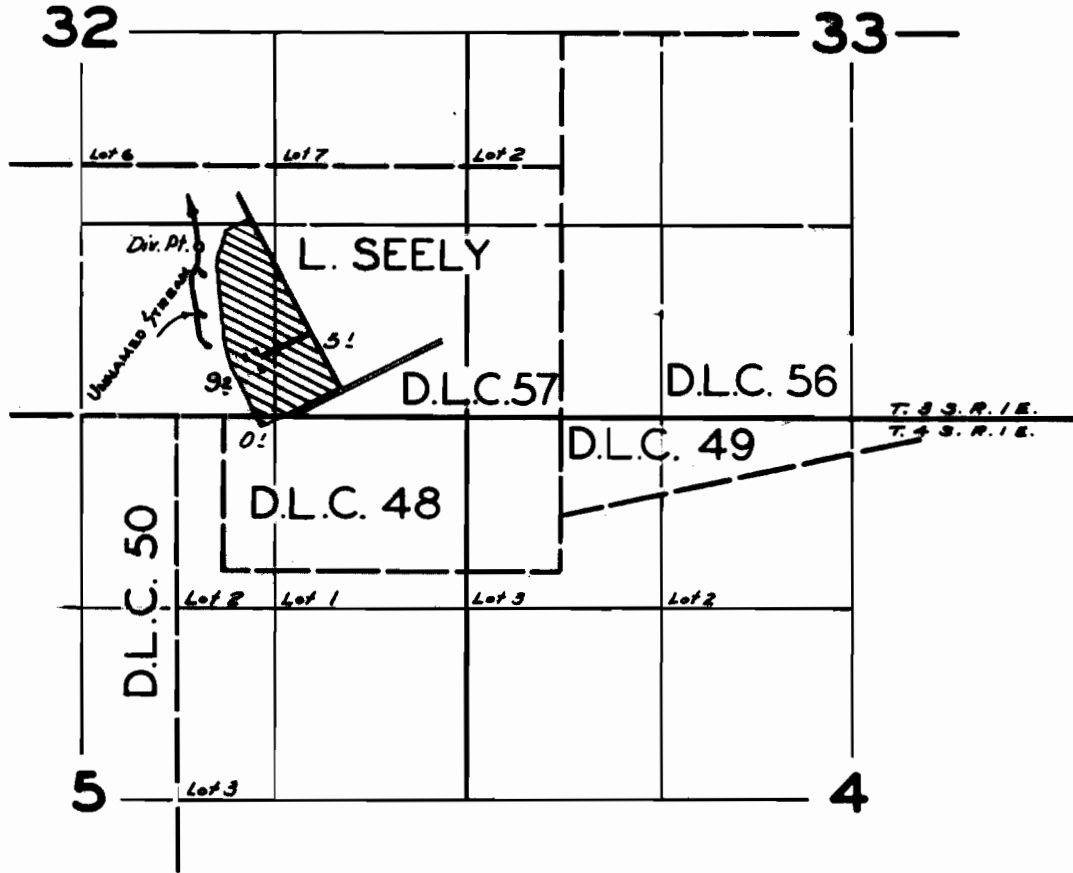

FINAL PROOF SURVEY
UNDER

Application No. 32206 Permit No. 25402
IN NAME OF

RAY A. PEARSON

Surveyed Mar. 28 1960, by *R. Jackson*