


T.2S. R.1E.W.M.

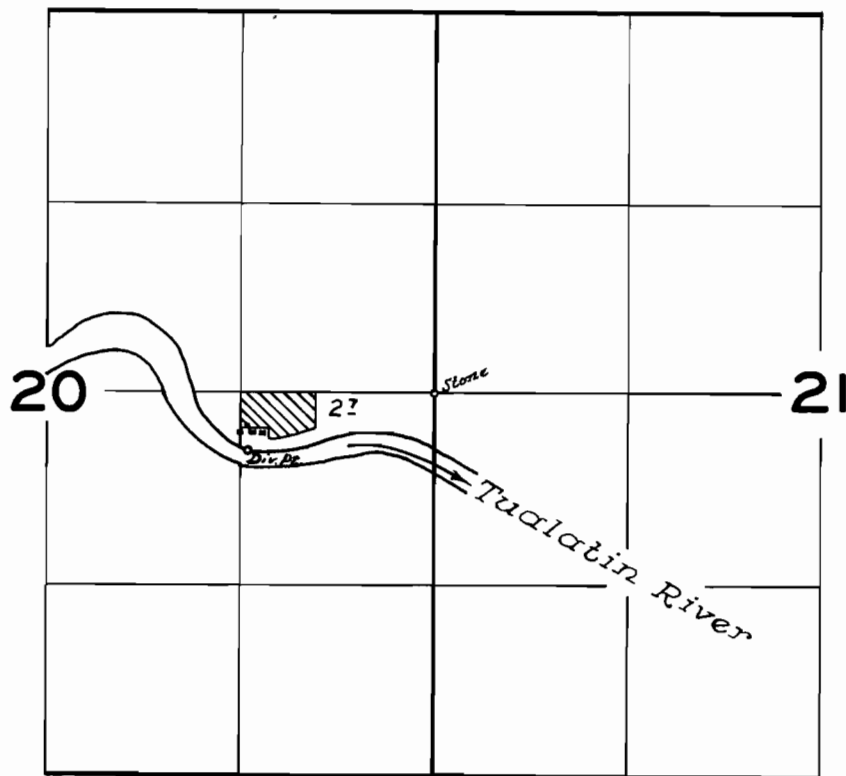

FINAL PROOF SURVEY
UNDER

Application No. 32376... Permit No. 25565...
IN NAME OF

SAM MASTROIENI

Surveyed April 28, 1960, by *R. Jackson*