


T. 2S. R. 3E.W.M.

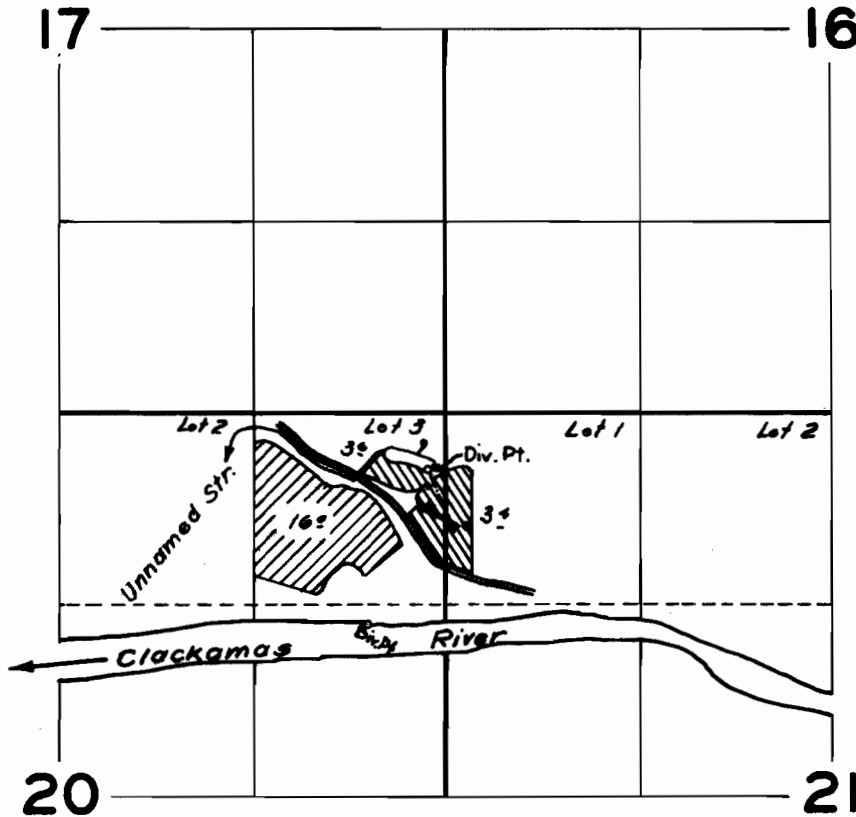

**FINAL PROOF SURVEY**  
UNDER

Application No. 33078 Permit No. 26189...  
IN NAME OF

**JOHN MARAS**

Surveyed April 1, 1960, by *R. Jackson*