


T.2S. R. 2E.W.M.

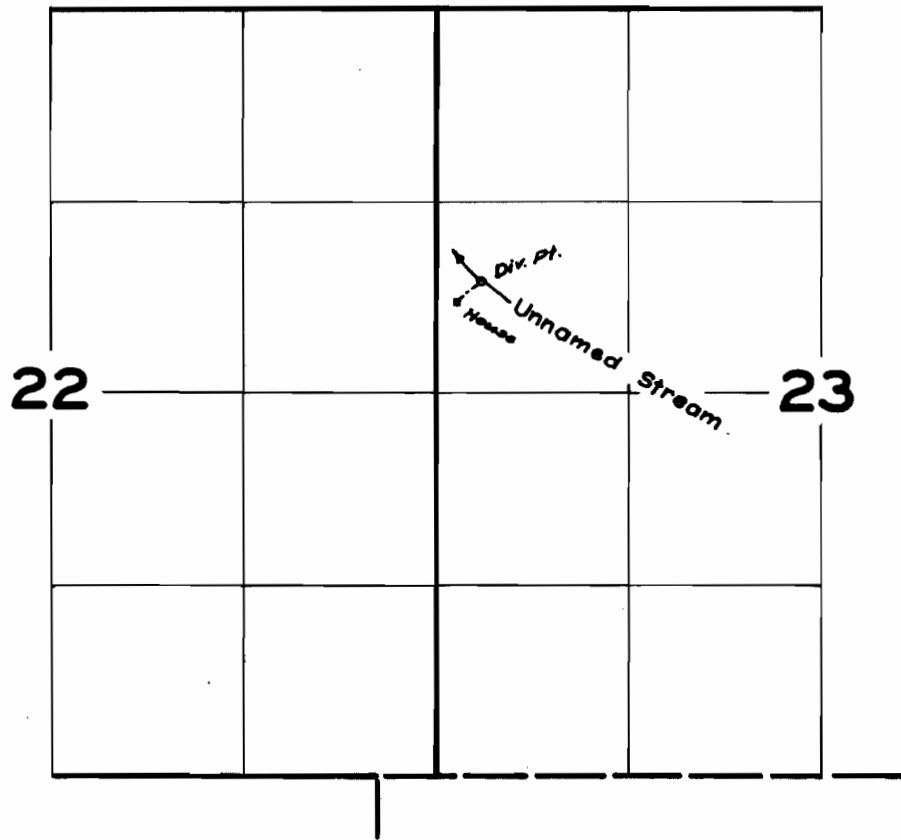

**FINAL PROOF SURVEY**  
UNDER

Application No. 33167. Permit No. 26234  
IN NAME OF

*LEON HERBERT & LEONORA C. SEWARD*

Surveyed 19 April 1960, by *R.H. Jackson*