


T.2S. R.3E.W.M.

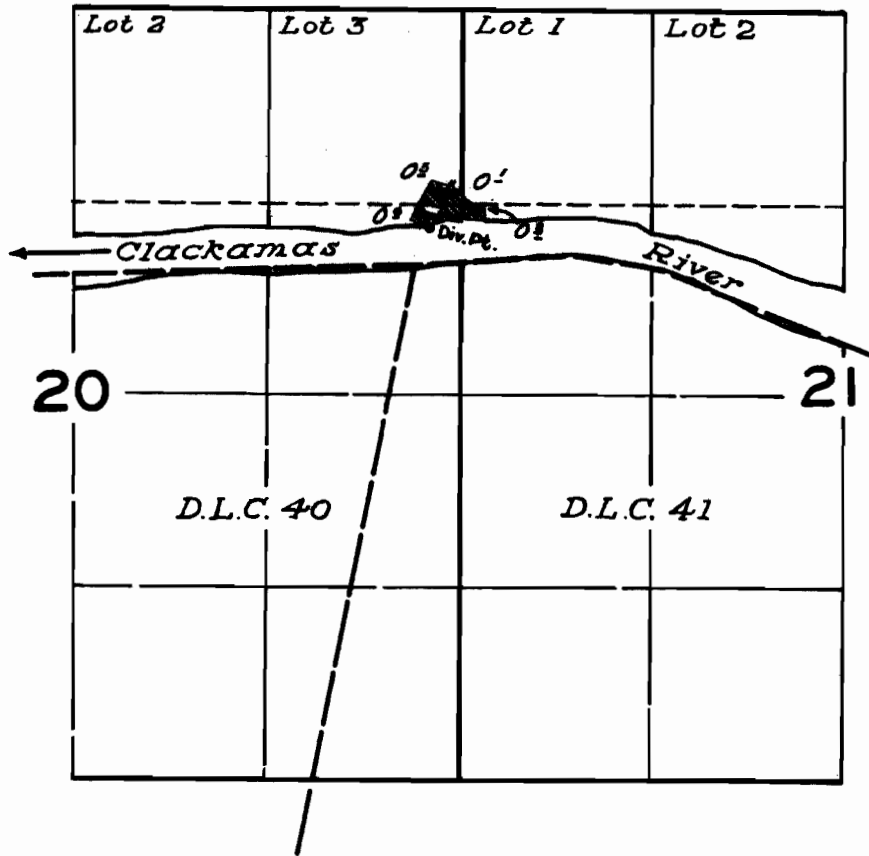

**FINAL PROOF SURVEY**  
UNDER

Application No. 35317... Permit No. 26356...  
IN NAME OF

ROGER W. WOODYARD

Surveyed April 29 1980, by RH Jackson