


T.25S. R.13W.W.M.

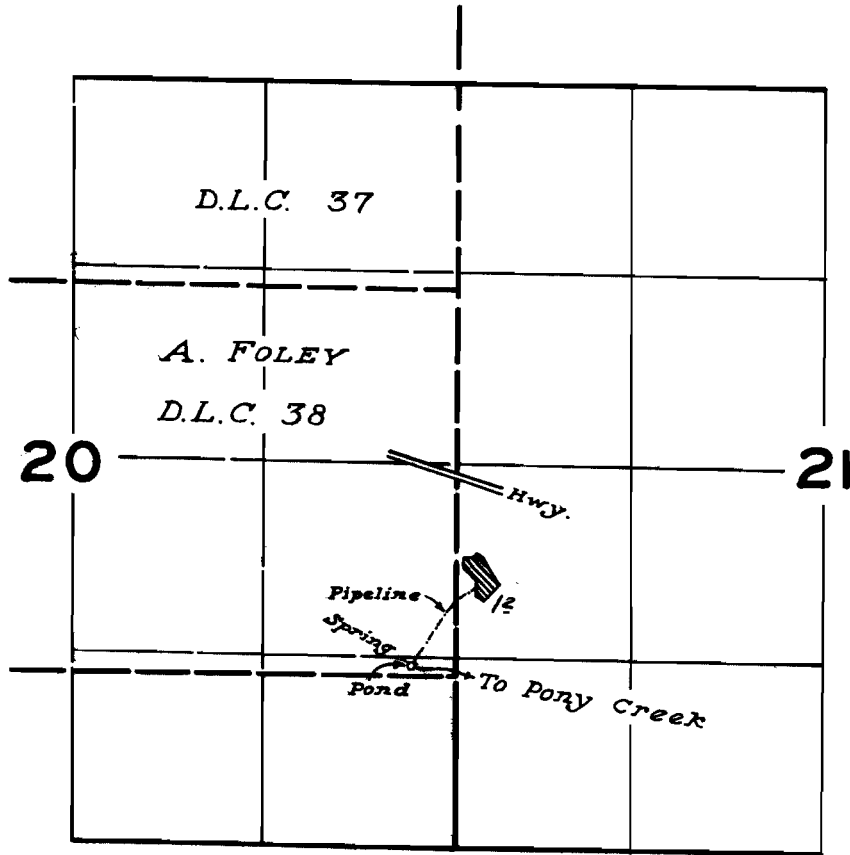

**FINAL PROOF SURVEY**  
UNDER

Application No. 22099. Permit No. 17371....  
IN NAME OF

DOW BECKHAM

Surveyed June 10, 1960, by R. Jackson