


T.26S. R.14 W.W.M.

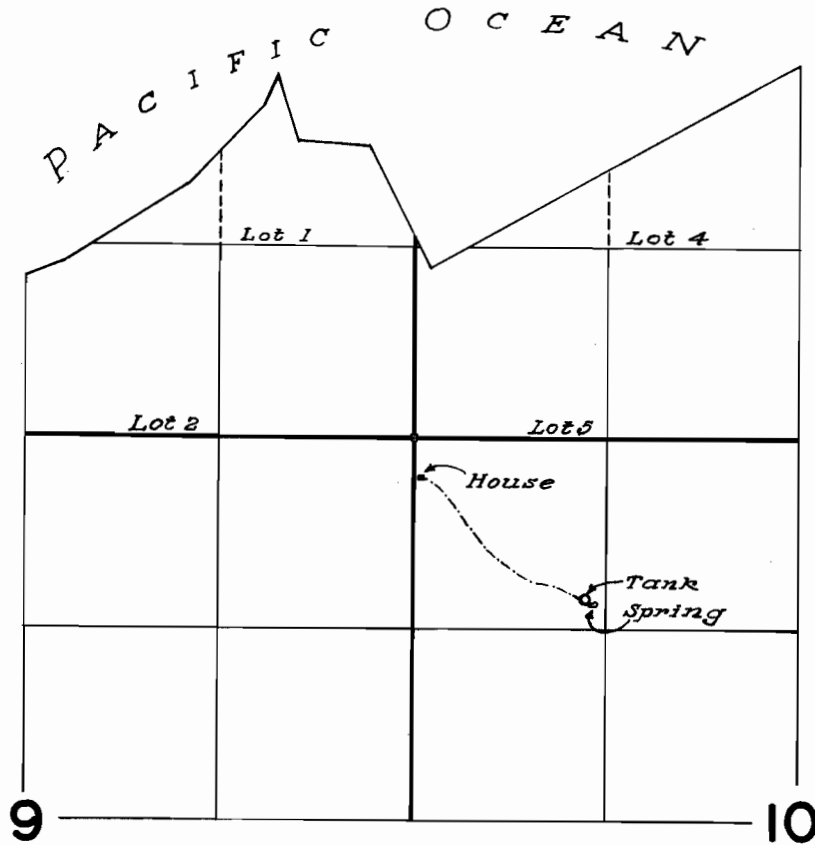

**FINAL PROOF SURVEY**  
UNDER

Application No. 23.26.2 Permit No. 18.35.8...  
IN NAME OF

**DONALD JAMES**

Surveyed June 10, 1960, by *R. Jackson*